


MODEINA STAGE 18


CITY OF MELTON

22 Business Park Drive Notting Hill 3168
A.C.N. 006 550 803
E: consulting@dpmvic.com.au
W: www.dpmvic.com.au
T: (03) 9538 5000

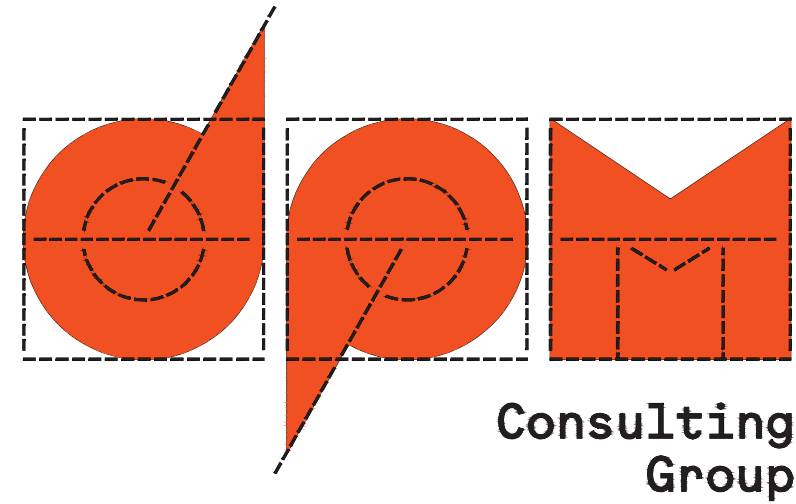

DRAWING INDEX


1275/18/NE/1	COVER SHEET AND LOCALITY PLAN
1275/18/NE/2	LAYOUT PLAN & SERVICES OFFSET TABLE
1275/18/NE/3	SERVICES PLAN
1275/18/NE/4	INTERSECTION DETAILS
1275/18/NE/5	GENERAL NOTES & PAVEMENT COMPOSTIONS
1275/18/NE/6	TYPICAL SECTIONS & MISCELLANEOUS DETAILS
1275/18/NE/7	DOMINION DRIVE - LONGITUDINAL SECTION
1275/18/NE/8	DOMINION DRIVE - CROSS SECTIONS
1275/18/NE/9	EMPIRE AVENUE - LONGITUDINAL SECTION
1275/18/NE/10	EMPIRE AVENUE - CROSS SECTIONS - SHEET 1 of 2
1275/18/NE/11	EMPIRE AVENUE - CROSS SECTIONS - SHEET 2 of 2
1275/18/NE/12	DRAINAGE LONGITUDINAL SECTIONS & PIT SCHEDULE
1275/18/NE/13	SIGNAGE & LINEMARKING PLAN

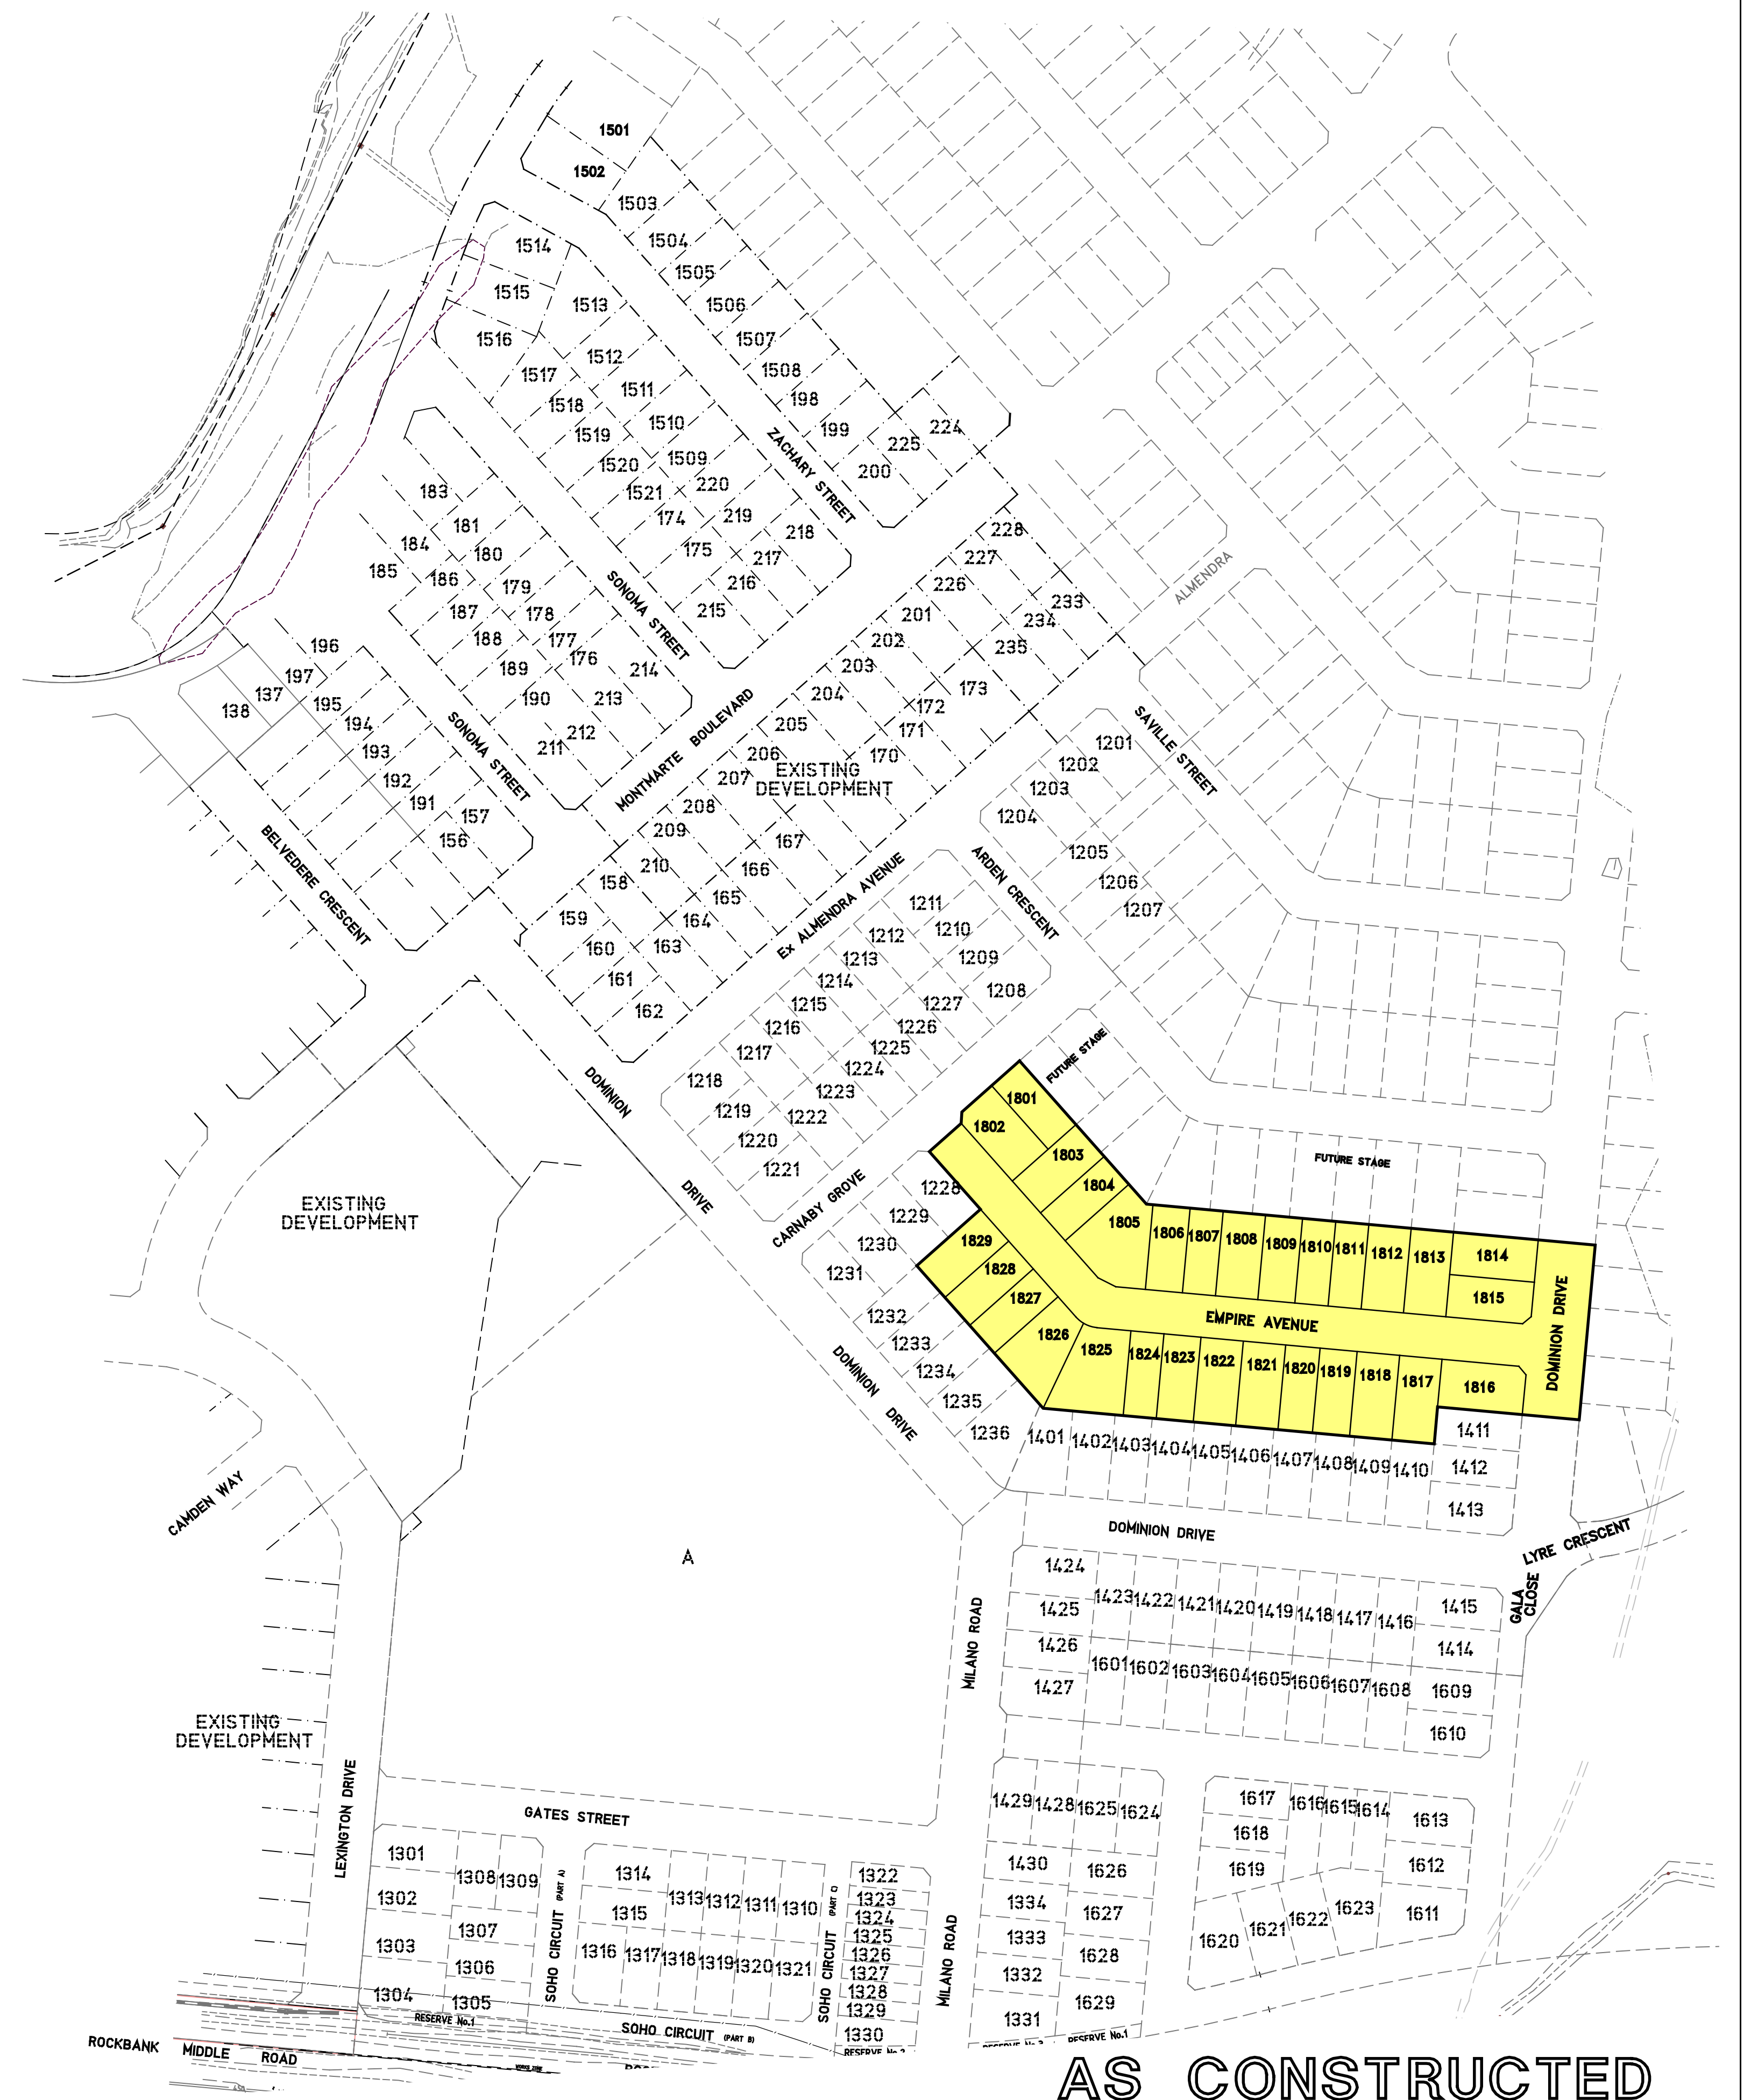


AS CONSTRUCTED

DRAWING No. 1275/18/NE/1

MELWAYS REF. 25 A1

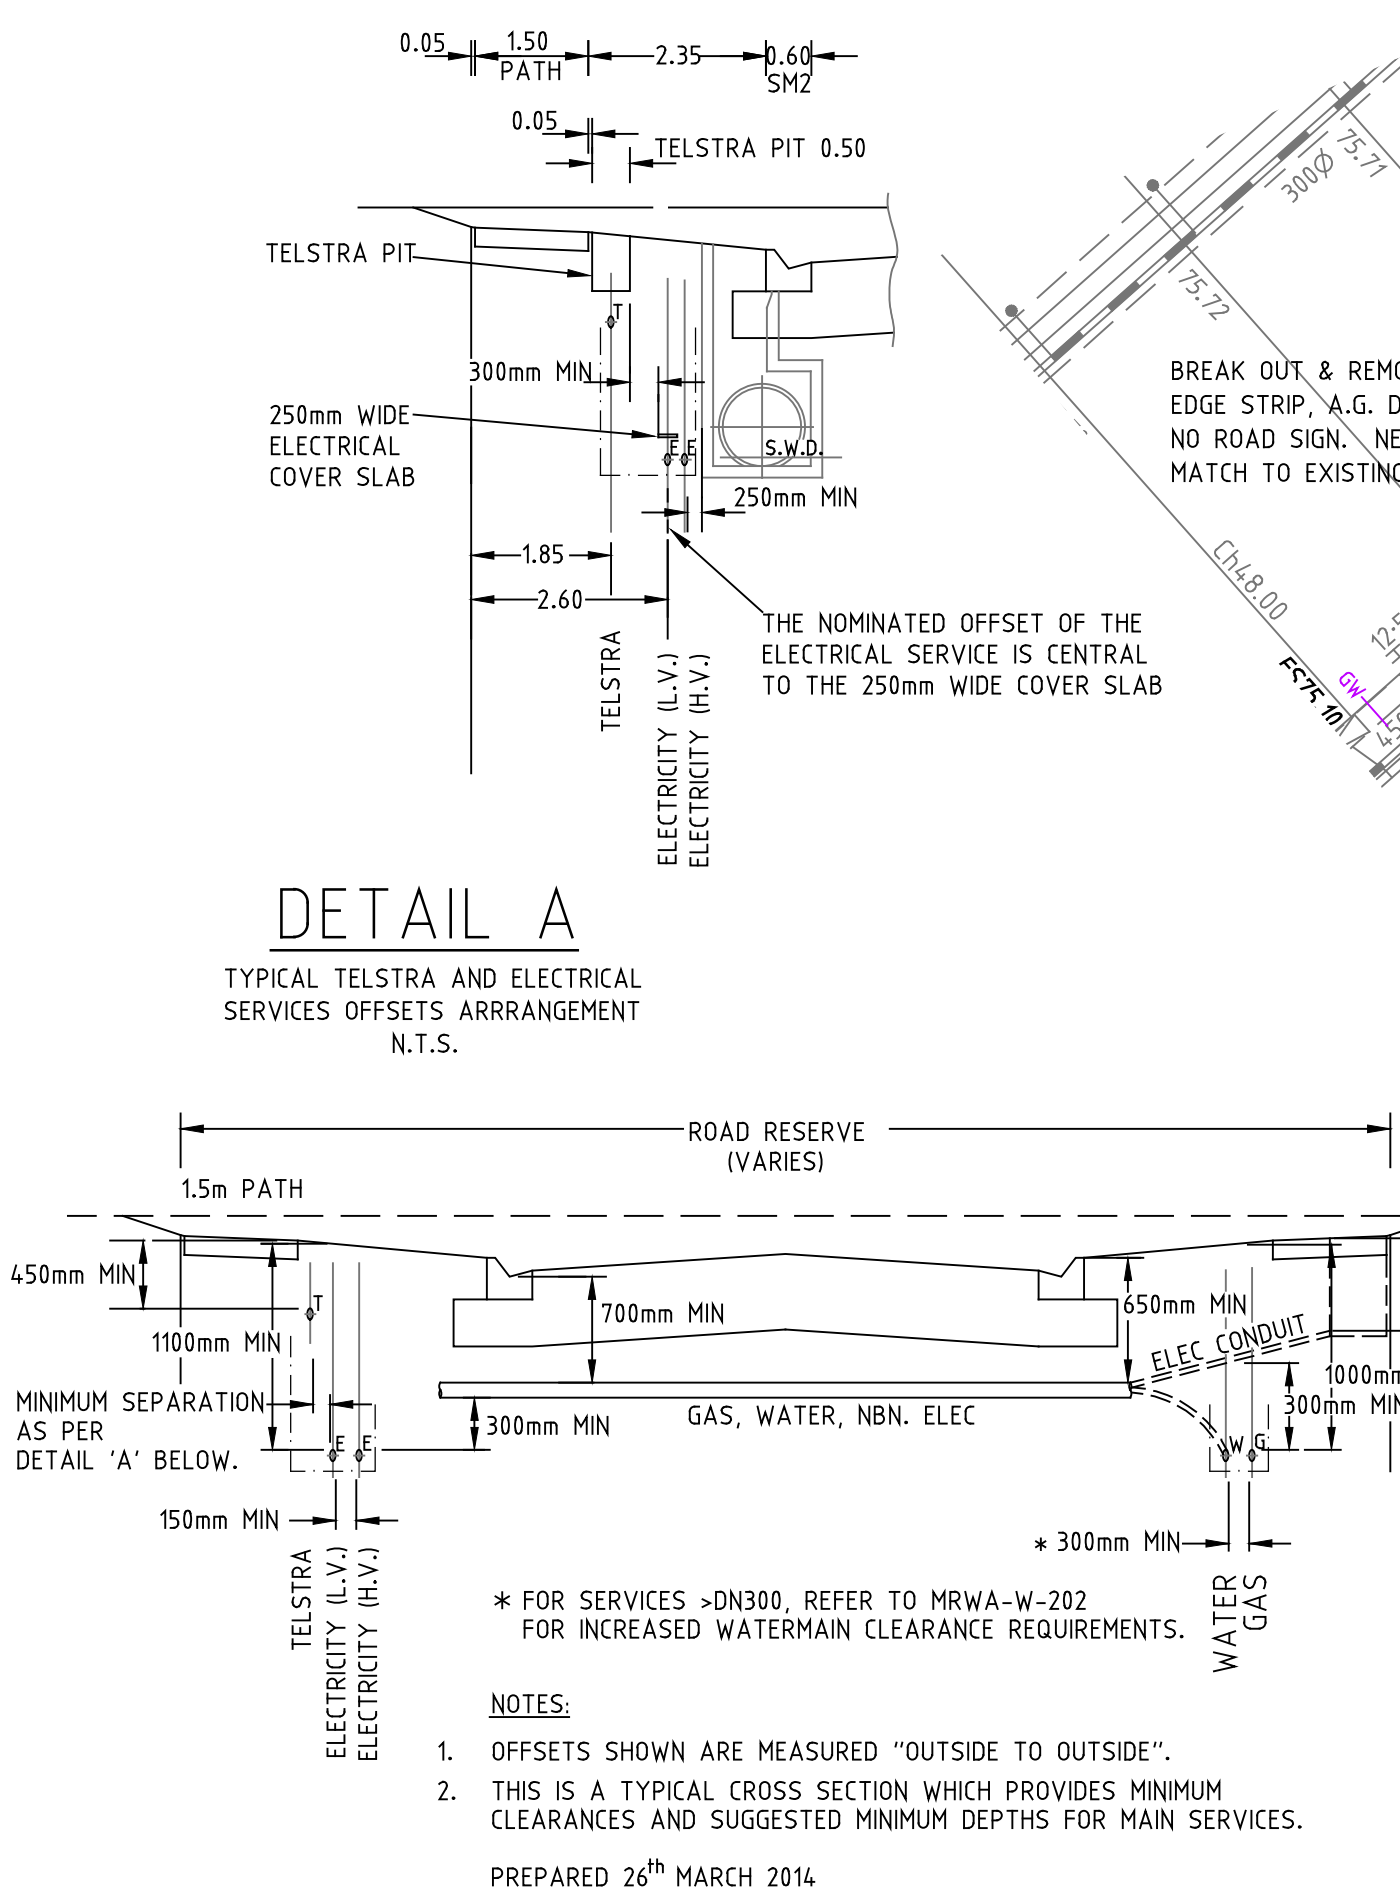


THESE DRAWINGS ARE TO BE USED ONLY FOR THE PURPOSE FOR WHICH THEY WERE INTENDED.
NO RESPONSIBILITY WILL BE BORNE BY THE ENGINEERING CONSULTANT SHOULD THESE DRAWINGS
BE USED FOR ANY OTHER PURPOSE.

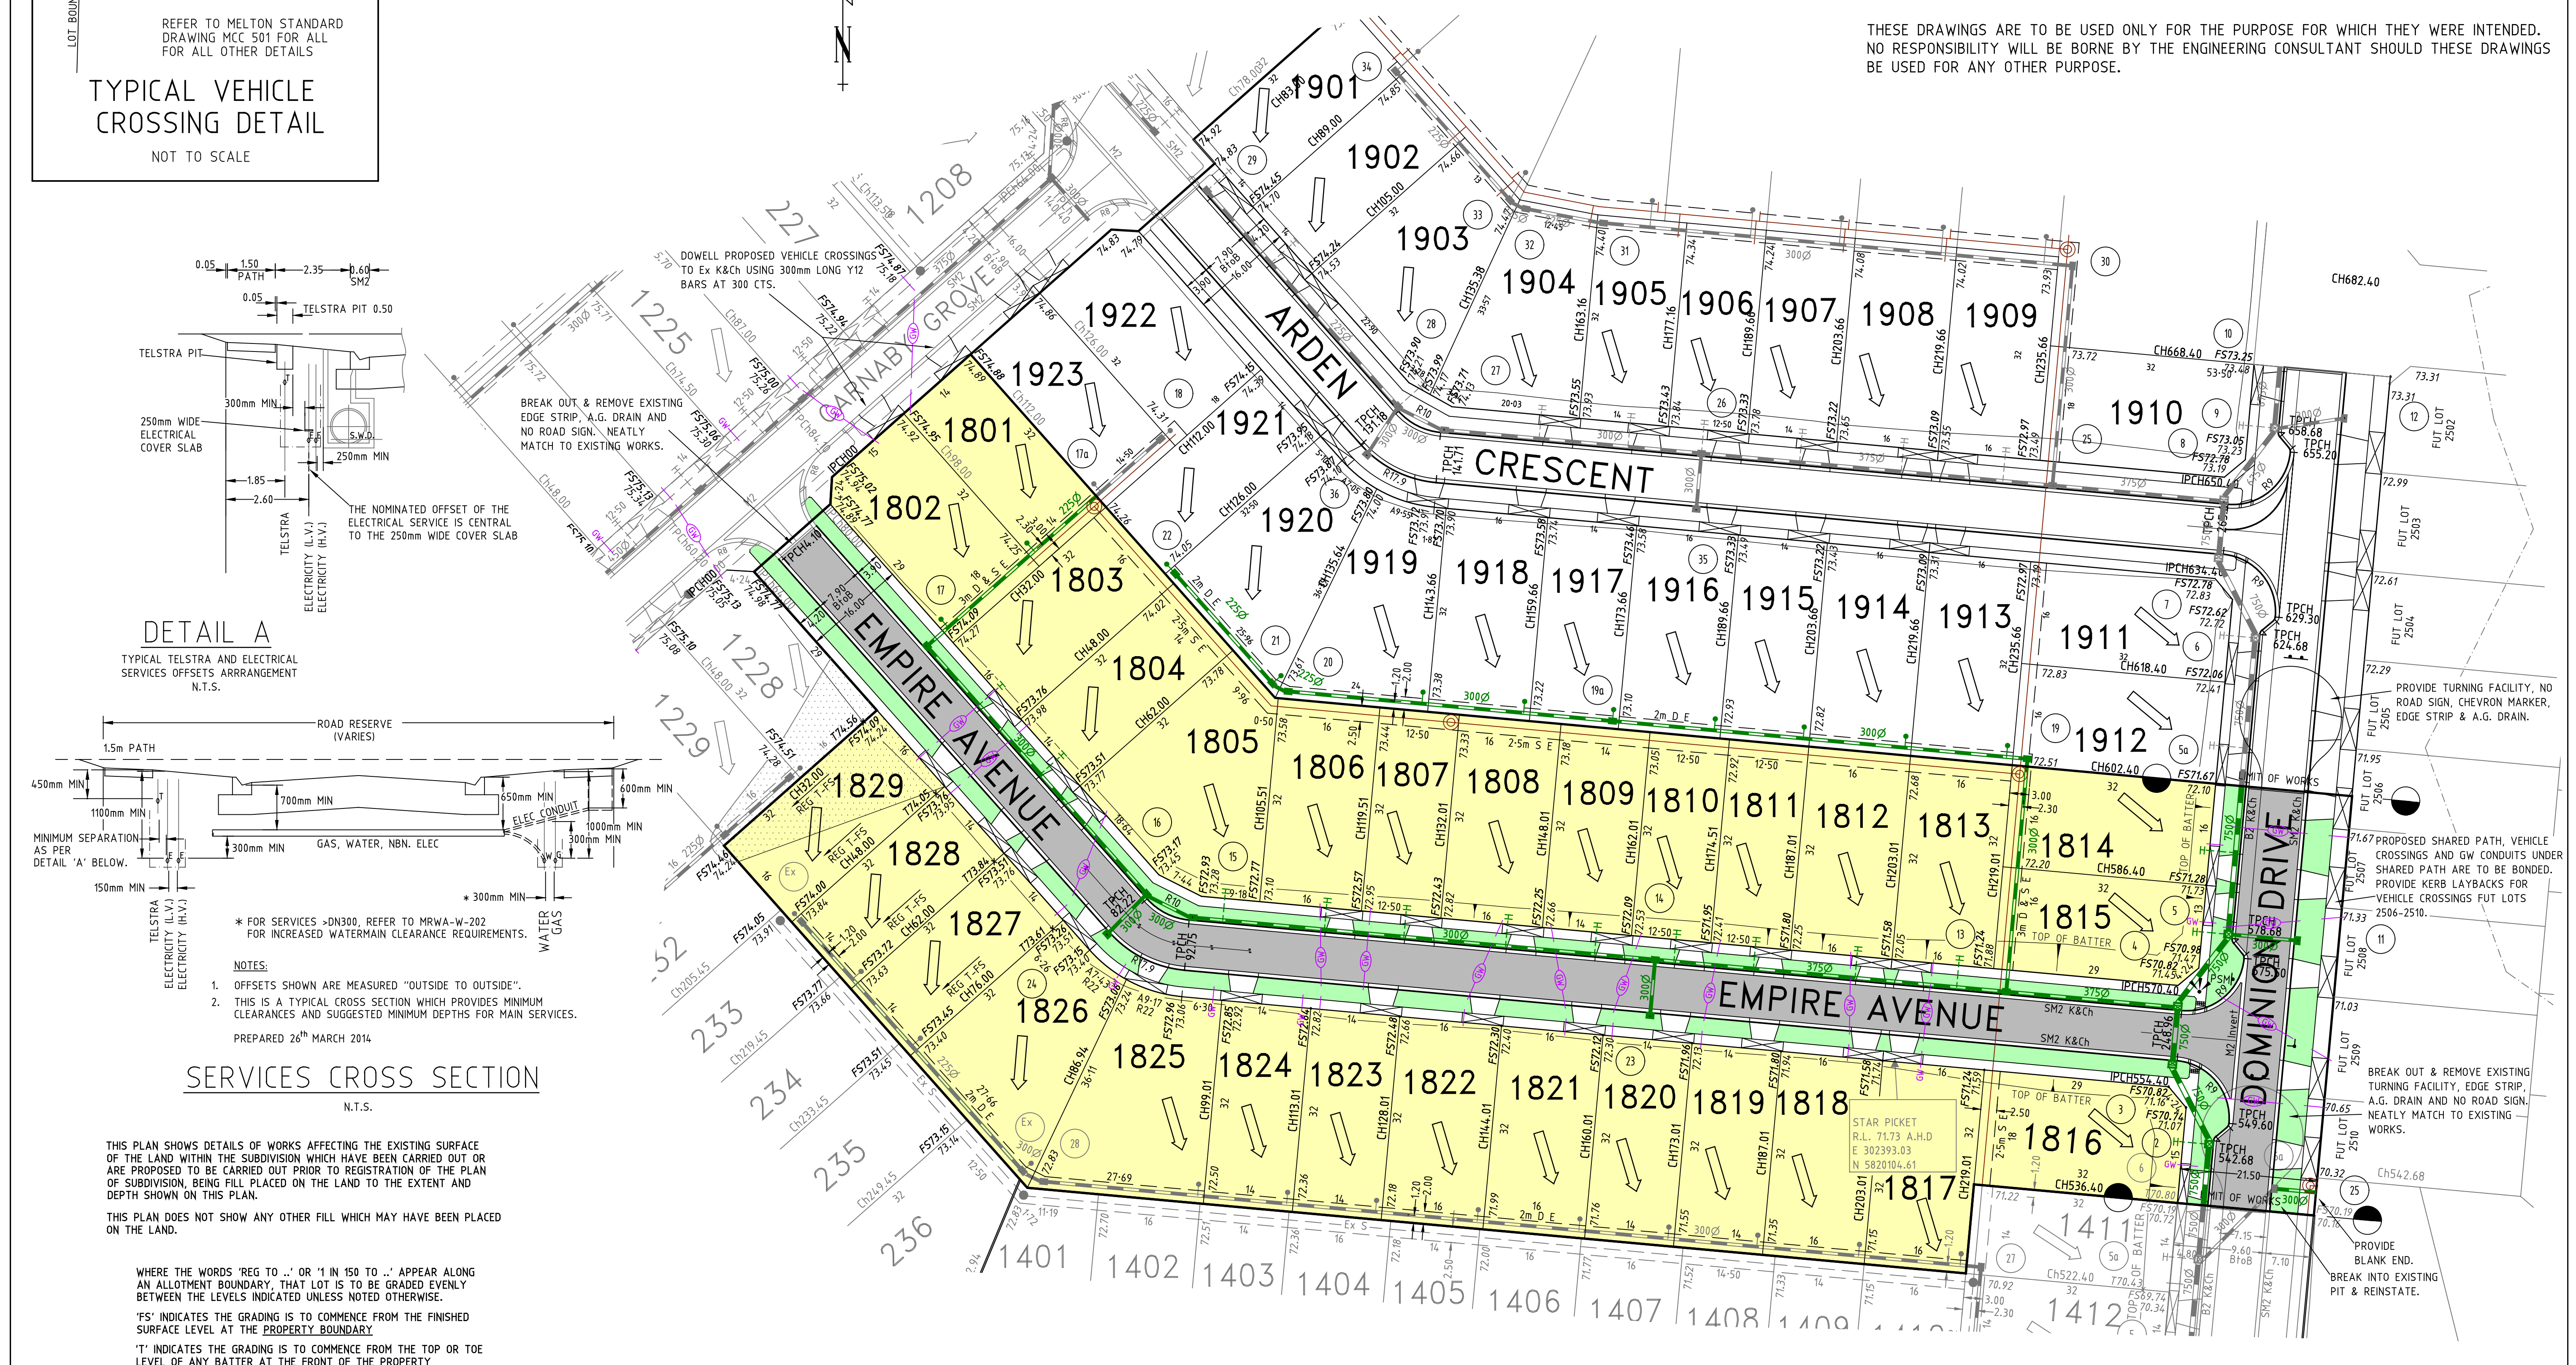

LAYOUT PLAN

AS CONSTRUCTED

C7 AS CONSTRUCTED ISSUE		10-4-19	J.B.			 SCALE 1:500 AT A1 SIZE			
C6	MINOR AMENDMENTS, XING LOT 1825 RELOCATED	2-7-18	J.B.					22 Business Park Drive Notting Hill 3168 A.C.N. 006 550 803 E: consulting@dpmvic.com.au W: www.dpmvic.com.au T: (03) 9538 5000	
C5	LOT 1824 VEHICLE CROSSING RELOCATED	16-5-18	J.B.	LEGEND 					
C4	MINOR AMENDMENTS	8-2-18	J.B.					DRAWN: J.BEVERIDGE DESIGNED: J.BEVERIDGE CHECKED: L.PAPAZOIS AUTHORISED: T.DAVOLI DATE: 20-10-2017	
C3	COUNCIL REQUIREMENTS	5-2-18	J.B.					AUTHORITY: CITY OF MELTON PROJECT: MODEINA STAGE 18	
C1	COUNCIL REQUIREMENTS	15-1-18	J.B.					DETAILS: LAYOUT PLAN & SERVICES OFFSET TABLE	
P1	PRELIMINARY ISSUE	20-10-17	L.P.					SCALE 1:500 LEVEL DATUM AHD SHEET 2 OF 13 DRAWING No. 1275/NE/18/2	
REV.	REVISION	DATE	APPD.					REV.	

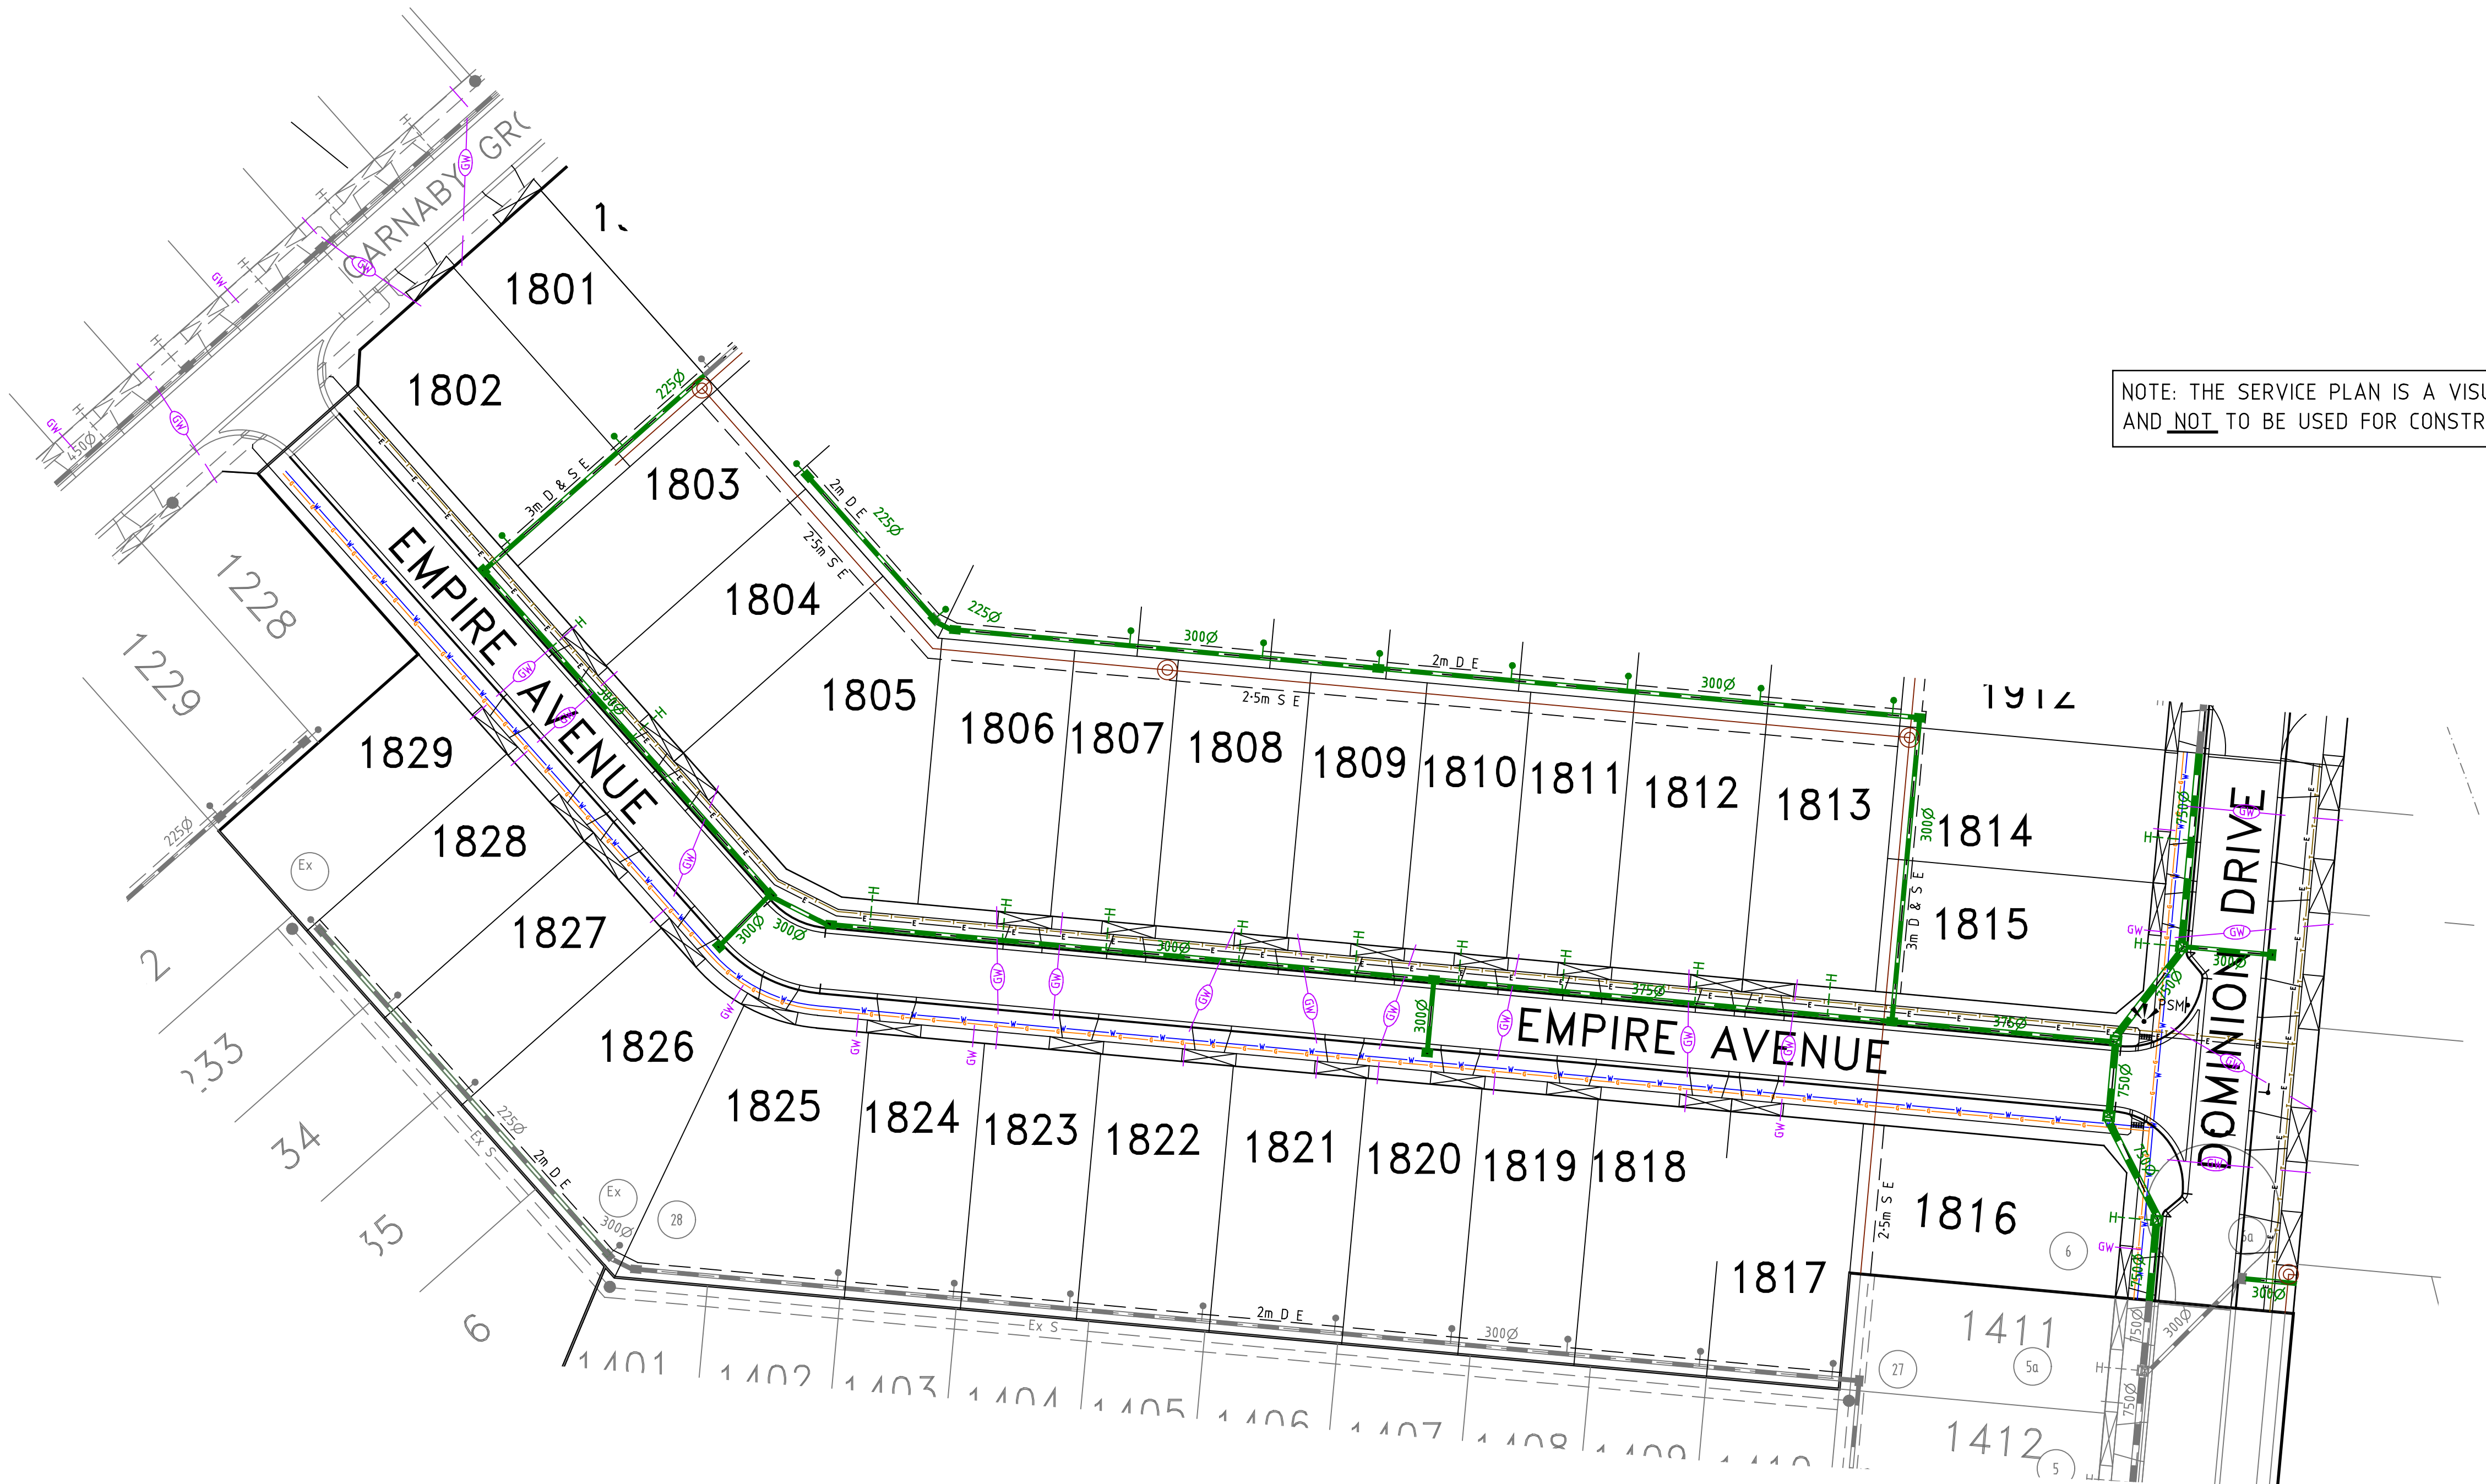

NOTE: THE SERVICE PLAN IS A VISUAL PLAN ONLY
AND NOT TO BE USED FOR CONSTRUCTION PURPOSES



AS CONSTRUCTED

C4	AS CONSTRUCTED ISSUE	10-4-19	J.B.											SCALE 1:500	
C3	1825 CROSSING AND FUT LOT LAYOUT CHANGES	13-7-18	J.B.											LEVEL DATUM AHD	
C2	VEHICLE CROSSING LOT 1824 RELOCATED	16-5-18	J.B.											SHEET 3 OF 13	
C1	COUNCIL REQUIREMENTS	15-01-18	J.B.											DRAWING No.	
P1	PRELIMINARY ISSUE	20-10-17	L.P.											1275/NE/18/03	
REV.	REVISION	DATE	APPD.											REV.	
														C4	


LEGEND									
	GAS MAIN		HOUSE DRAIN PROPOSED/EX.		CHAINAGES AND TANGENT POINTS				
	WATER MAIN		PROPERTY INLET, DRAINAGE PITS		EXISTING SURFACE LEVEL				
	RECYCLED WATER MAIN		EX./FUT. INLET, DRAINAGE PITS		FINISHED LEVEL (TITLE BOUNDARY)				
	ELECTRICITY CABLE		DRAINAGE PIT STAGE/NUMBER		DESIGN TOP/TOE OF BATTER LEVEL				
	TELECOMMUNICATIONS CABLE		SEWER LINE AND STRUCTURES		DESIGN PAVEMENT LEVEL				
	WATER CONDUIT		EX. SEWER LINE AND STRUCTURES		PROPOSED CONTOUR LINE & LEVEL				
	GAS CONDUIT		KERB AND CHANNEL		EXISTING CONTOUR LINE & LEVEL				
	RECYCLED WATER CONDUIT		EX./FUT. KERB AND CHANNEL		FILLING IN EXCESS OF 200mm				
	COMBINED SERVICES CONDUIT		KERB TO BE REMOVED OFFSITE		CATCH DRAIN AND INVERT LEVEL				
	T.B.M.		STREET SIGN		EX. BATTER				
	P.S.M.				PROP. BATTER				

22 Business Park Drive Notting Hill 3168
A.C.N. 006 550 803
E: consulting@dpmvic.com.au
W: www.dpmvic.com.au
T: (03) 9538 5000

DRAWN:	J.BEVERIDGE	AUTHORITY:	CITY OF MELTON
DESIGNED:	J.BEVERIDGE	PROJECT:	MODEINA STAGE 18
CHECKED:	L.PAPAZOIS	DETAILS:	SERVICES PLAN
AUTHORISED:	T.DAVOLI		
DATE:	20-10-2017		

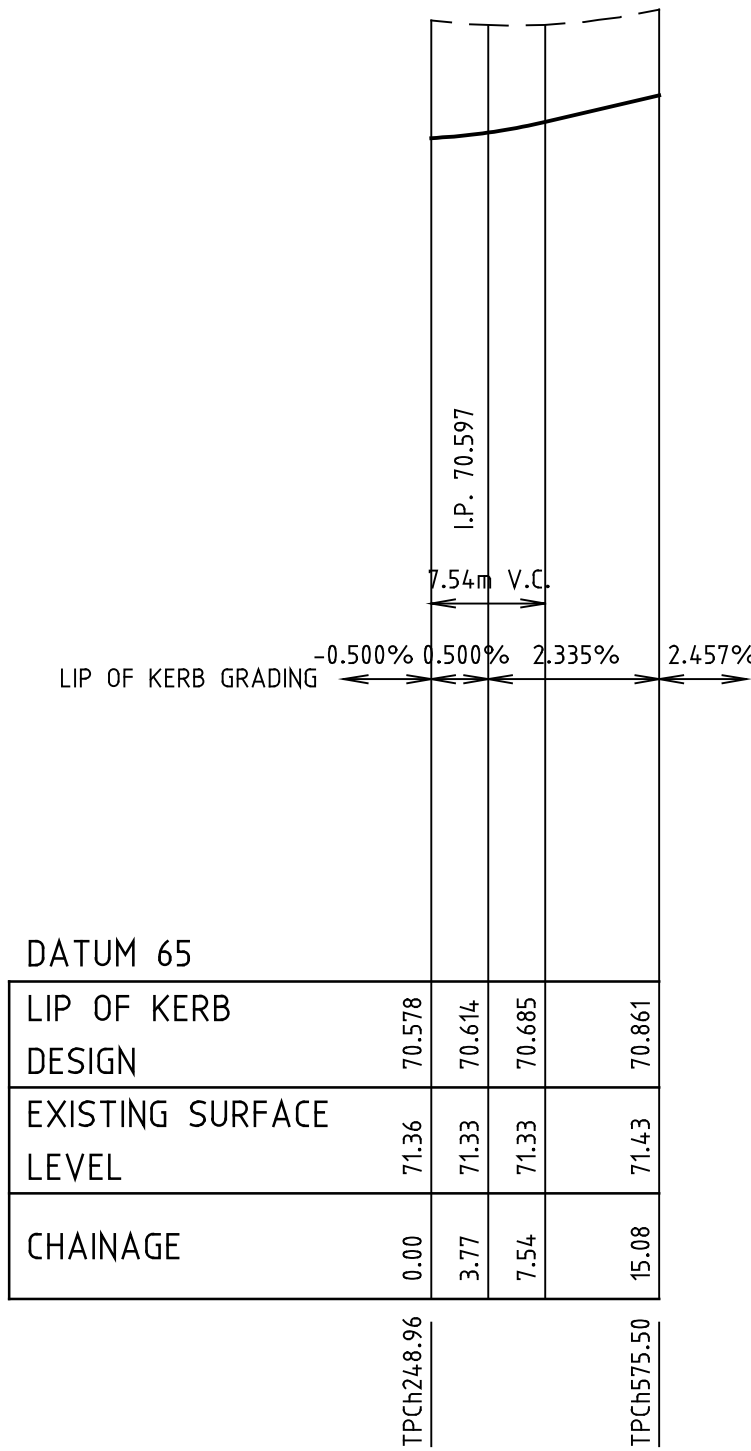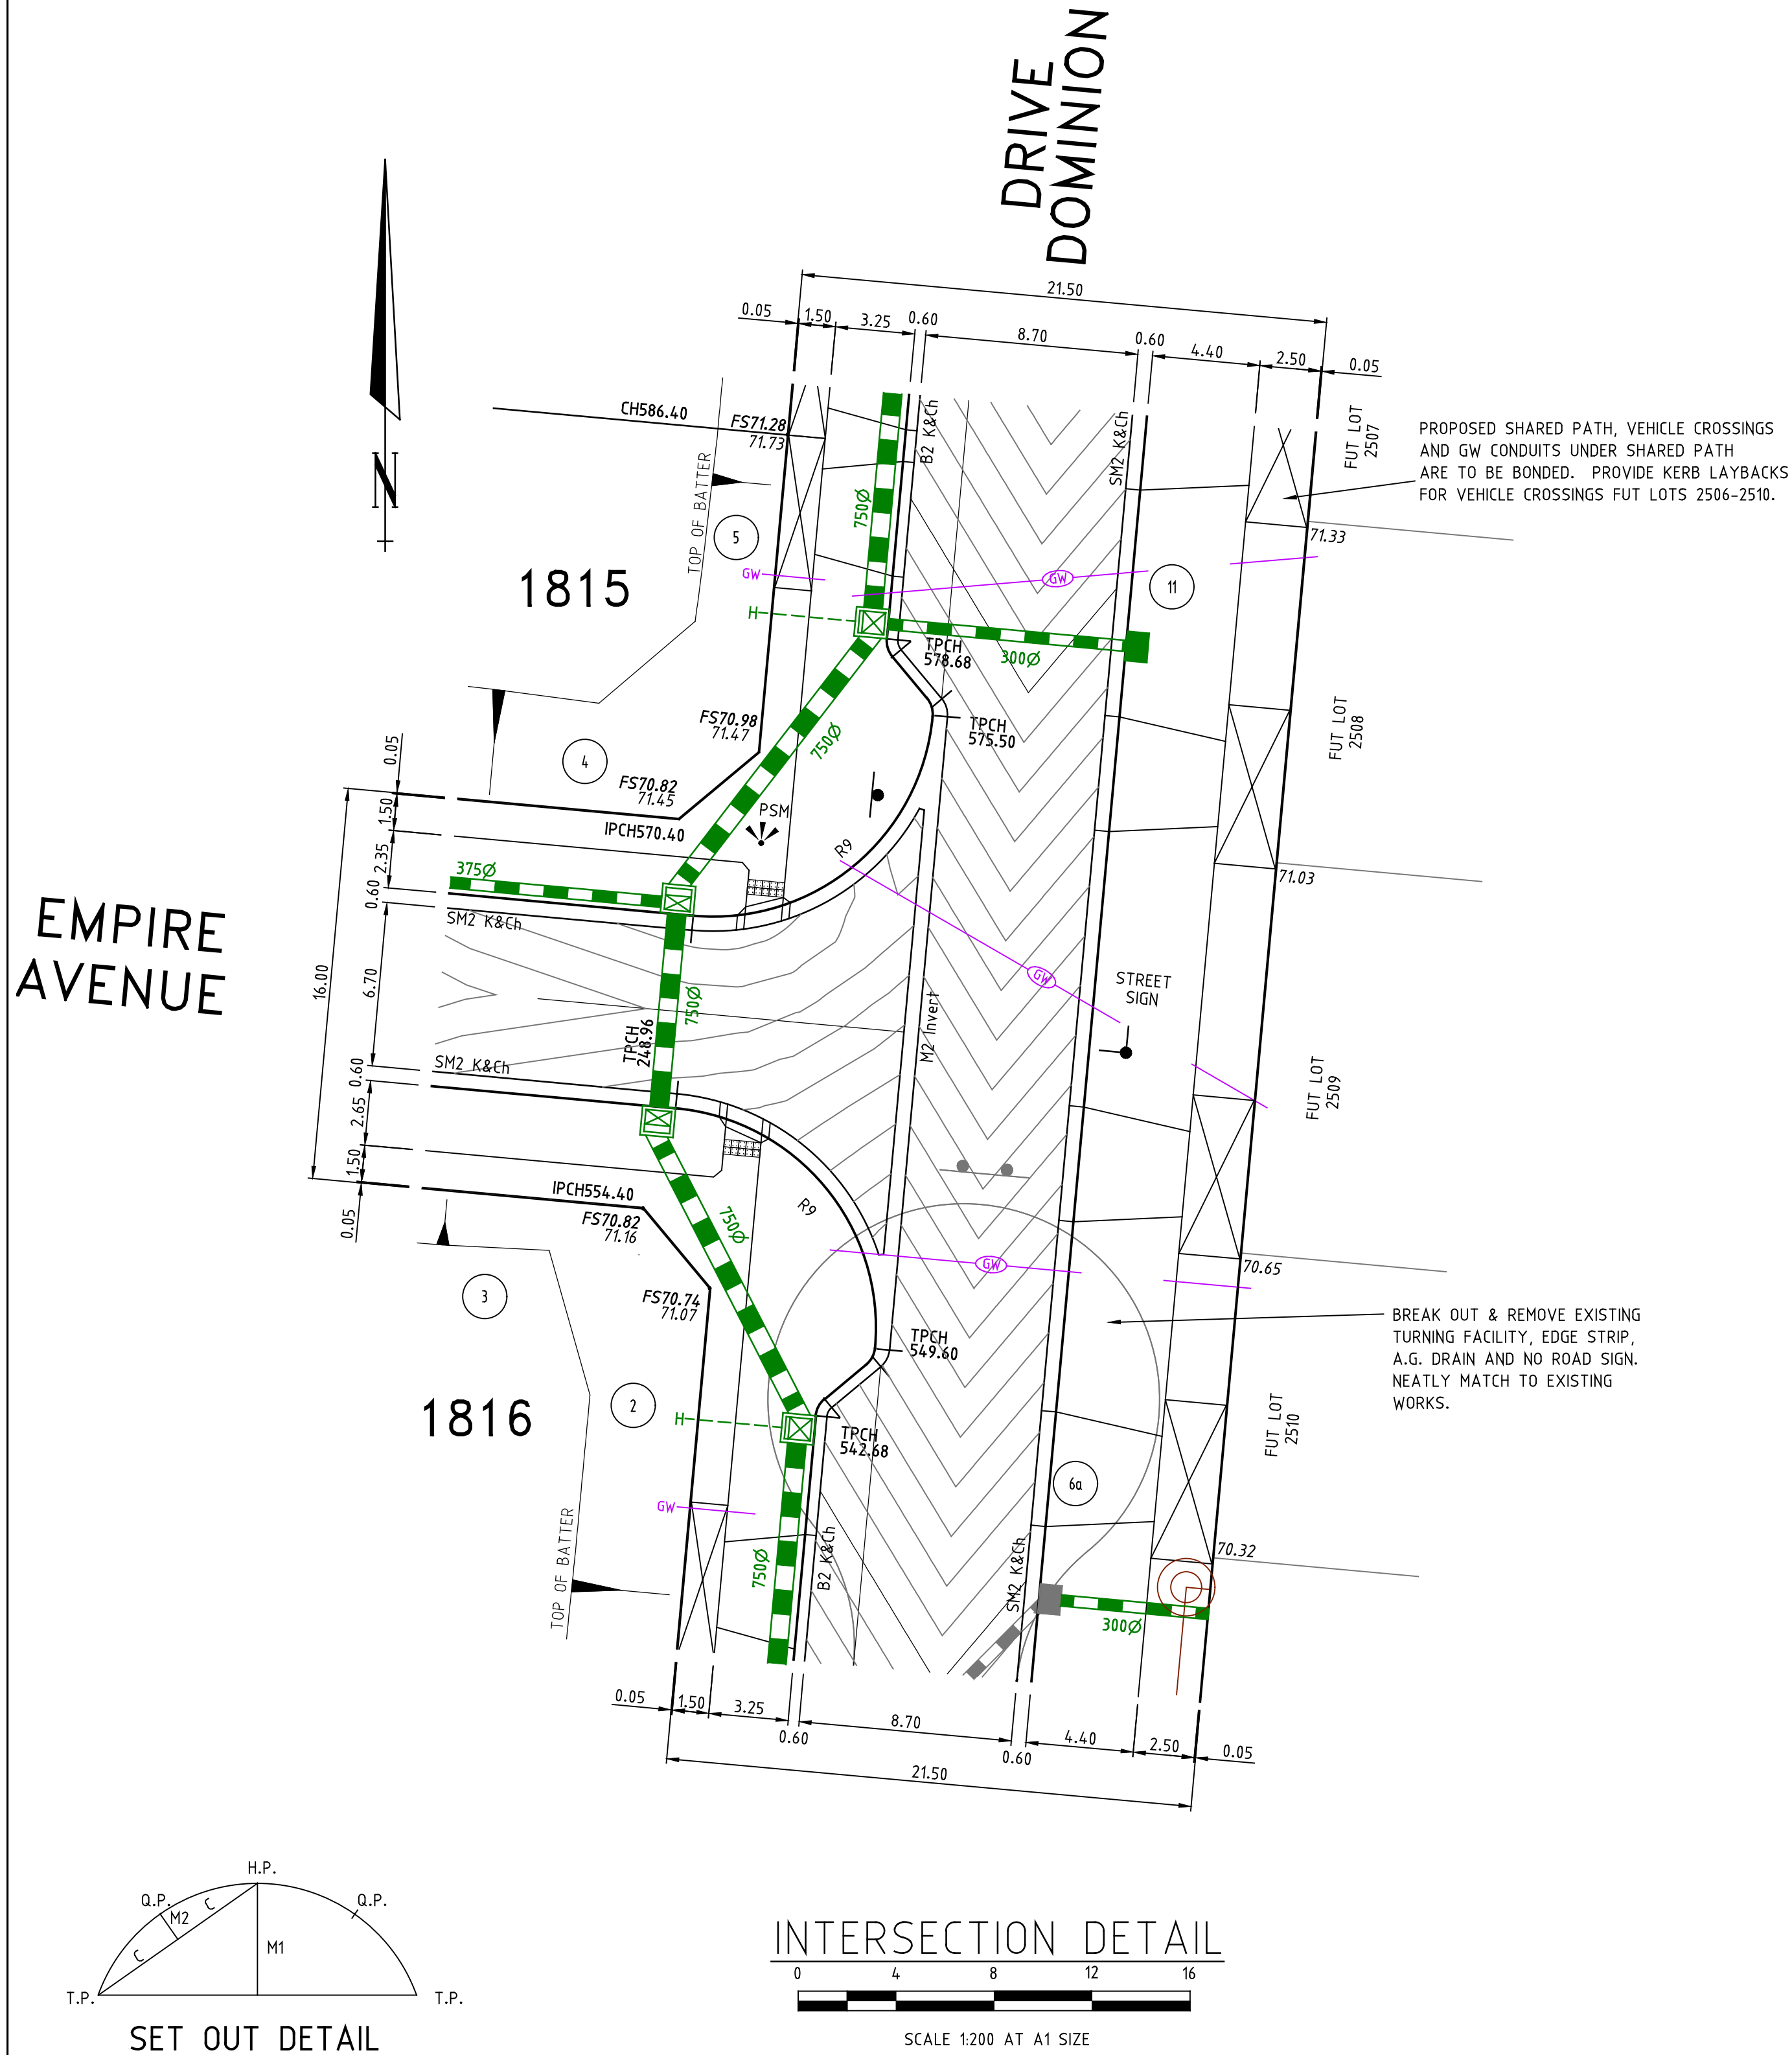


NORTH LIP OF KERB
LONGITUDINAL SECTION

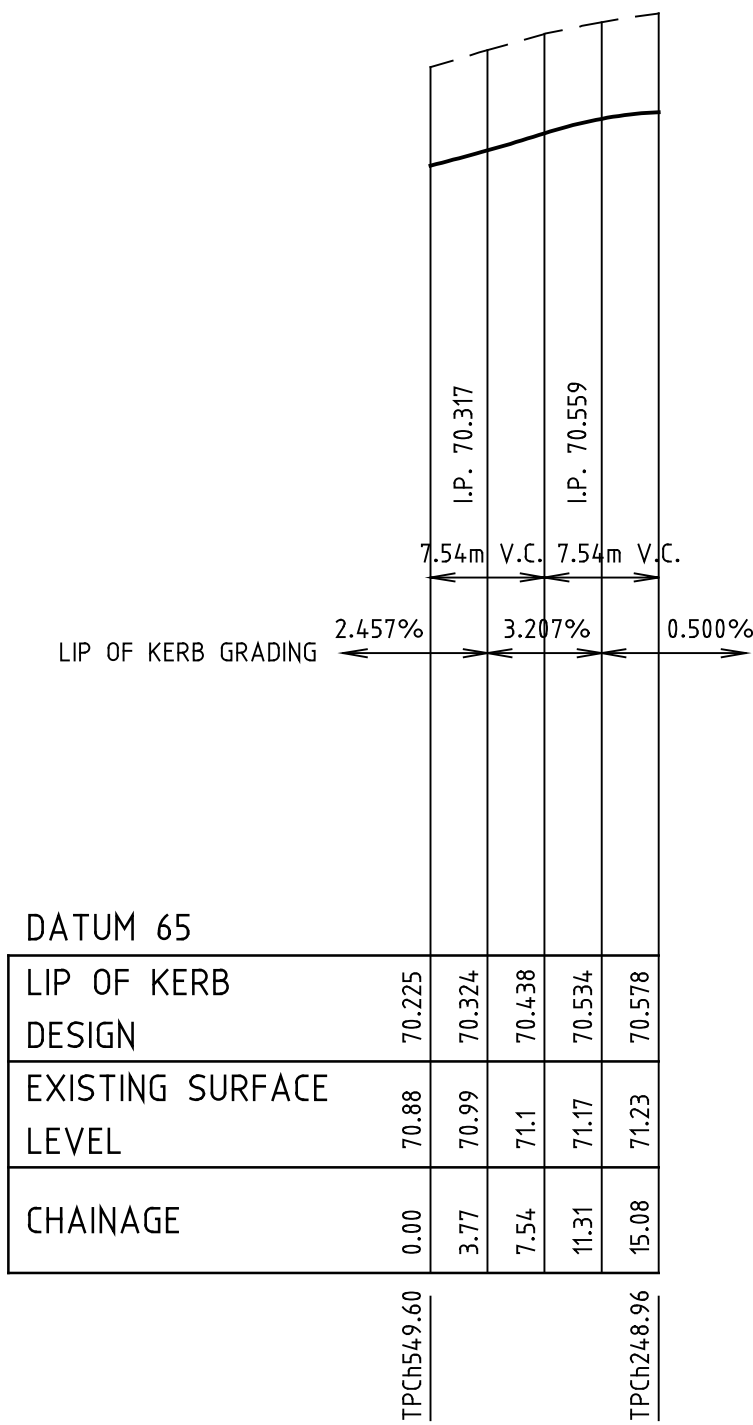


SOUTH LIP OF KERB
LONGITUDINAL SECTION

AS CONSTRUCTED

REV.	REVISION	DATE	APPD.	LEGEND	22 Business Park Drive Notting Hill 3168 A.C.N. 006 550 803 E: consulting@dpmvic.com.au W: www.dpmvic.com.au T: (03) 9538 5000	Consulting Group	DRAWN: J.BEVERIDGE DESIGNED: J.BEVERIDGE CHECKED: L.PAPAZOIS AUTHORISED: T.DAVOLI DATE: 20-10-2017	AUTHORITY: CITY OF MELTON PROJECT: MODEINA STAGE 18 DETAILS: INTERSECTION DETAILS	SCALE 1:200 LEVEL DATUM AHD SHEET 4 OF 13 DRAWING No. 1275/NE/18/4 REV. C3
------	----------	------	-------	--------	--	------------------	--	--	--

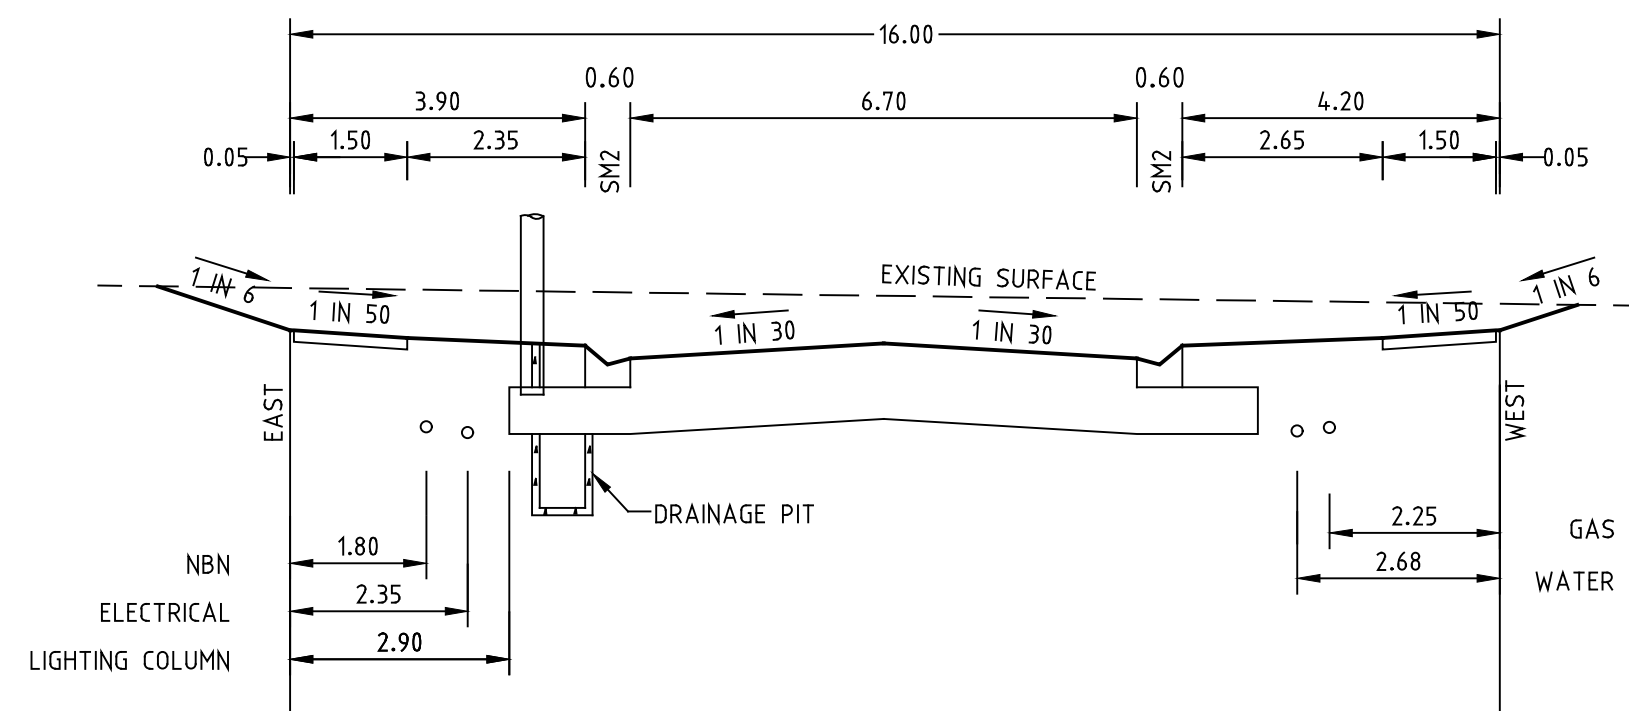


EMPIRE AVENUE

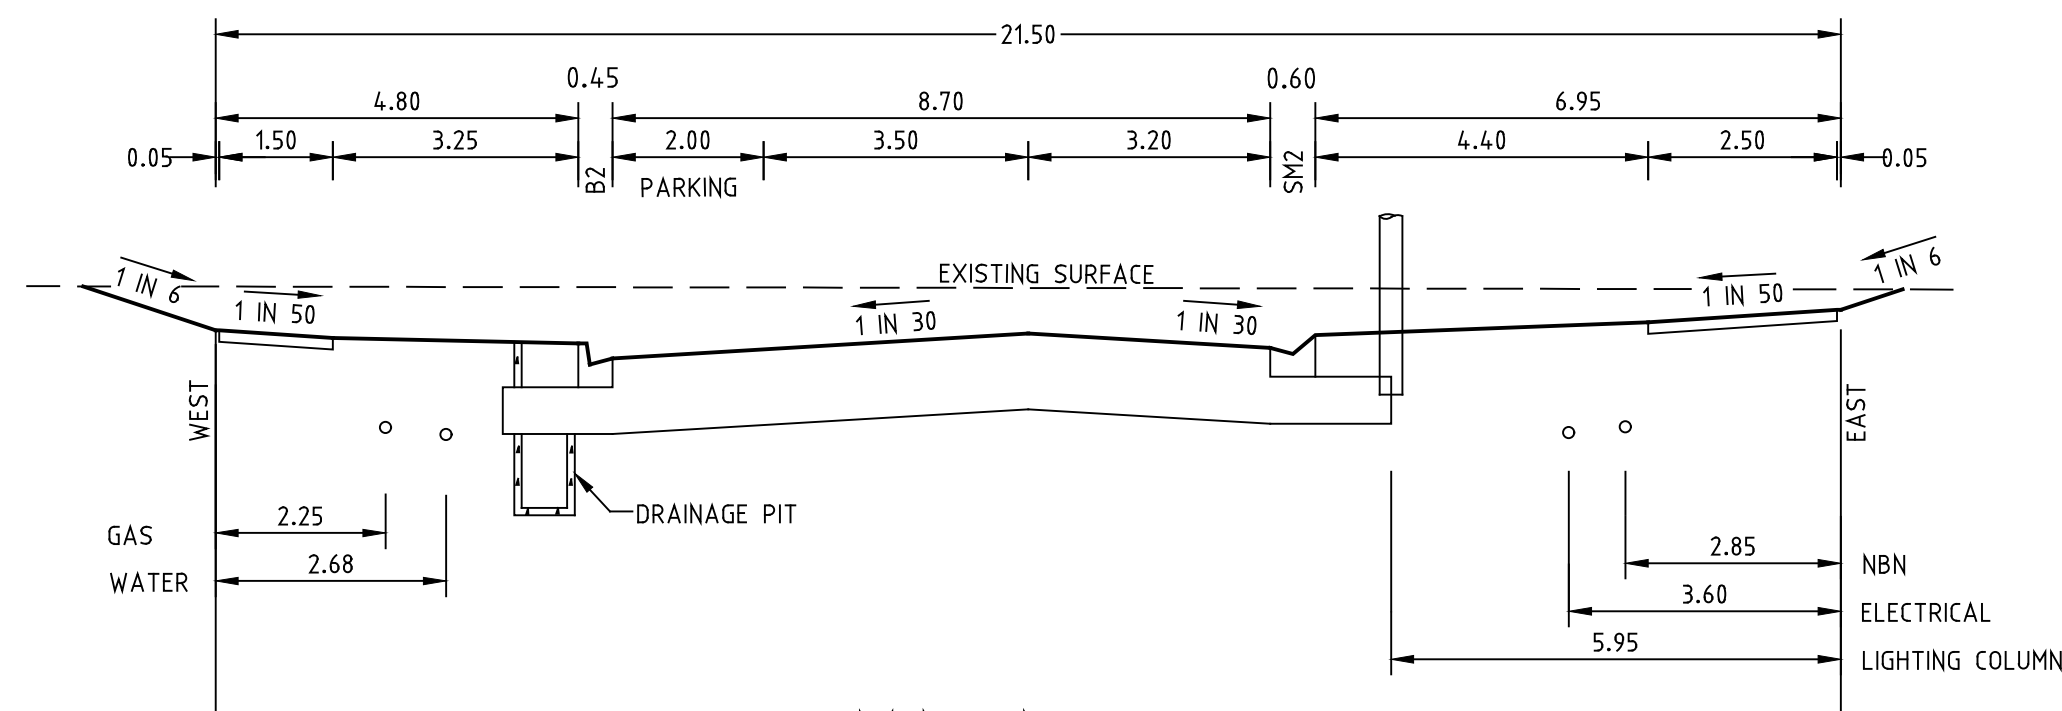


DOMINION DRIVE

TYPICAL SECTIONS


NOT TO SCALE

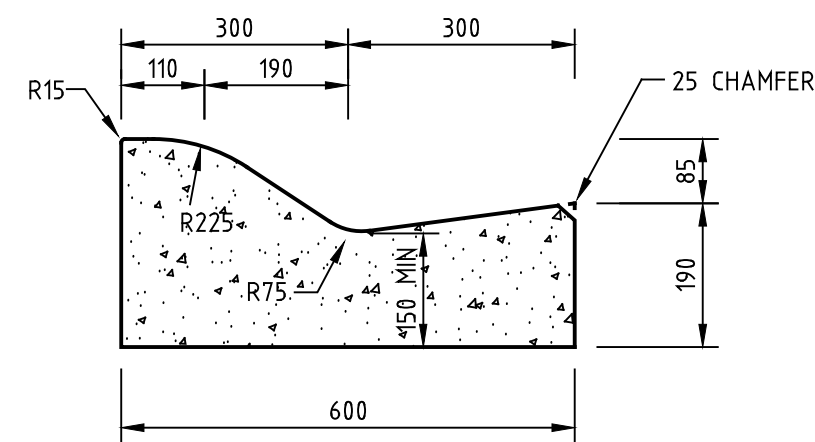


SM2 K&Ch PROFILE

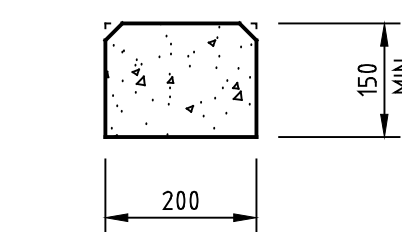

EDGE STRIP PROFILE

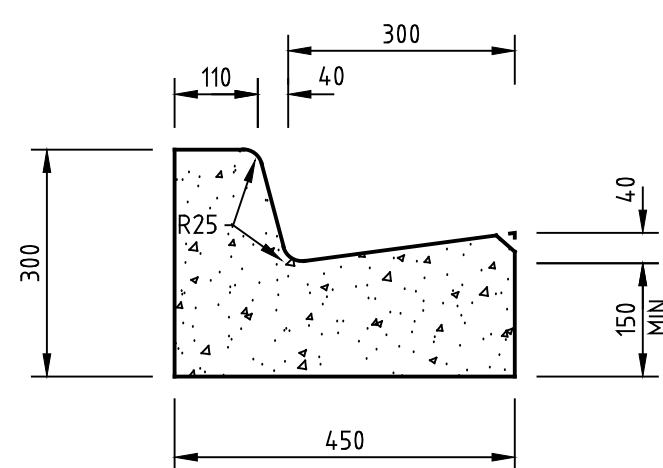


B2 KERB PROFILE

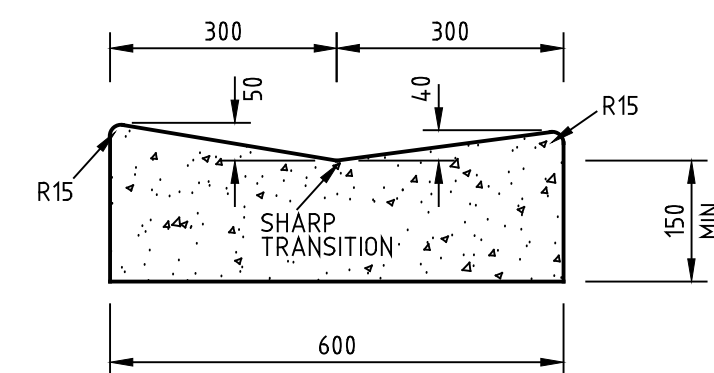

M2

KERB DETAILS

N.T.S.





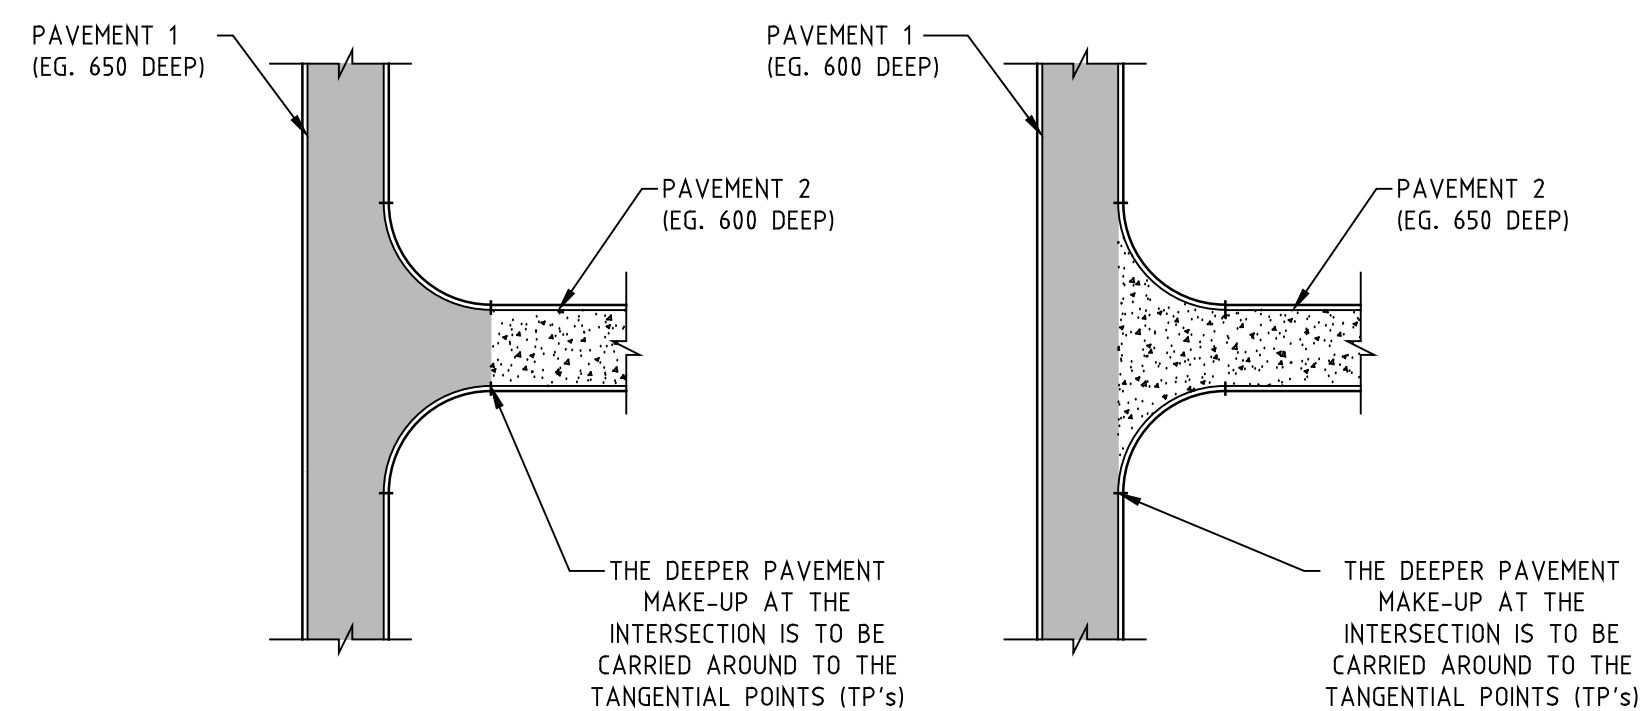


TYPICAL PAVEMENT EXTENT ACROSS INTERSECTIONS

NOT TO SCALE


AS CONSTRUCTED

REV.	REVISION	DATE	APPD.	LEGEND	CHAINAGES AND TANGENT POINTS	22 Business Park Drive Notting Hill 3168 A.C.N. 006 550 803 E: consulting@dpmvic.com.au W: www.dpmvic.com.au T: (03) 9538 5000	Consulting Group	DRAWN: J.BEVERIDGE DESIGNED: J.BEVERIDGE CHECKED: L.PAPAZOIS AUTHORISED: T.DAVOLI DATE: 20-10-2017	AUTHORITY: CITY OF MELTON PROJECT: MODEINA STAGE 18 DETAILS: TYPICAL SECTIONS & MISCELLANEOUS DETAILS	SCALE NOT TO SCALE LEVEL DATUM AHD SHEET 6 OF 13 DRAWING No. 1275/NE/18/06 REV. C2
-	-	-	-	LEGEND	CHAINAGES AND TANGENT POINTS					
-	-	-	-	GAS MAIN	HOUSE DRAIN PROPOSED/EX.	20.06				
-	-	-	-	WATER MAIN	PROPERTY INLET, DRAINAGE PITS	20.06				
C2	AS CONSTRUCTED ISSUE	10-4-19	J.B.	RECYCLED WATER MAIN	EX./FUT. INLET, DRAINAGE PITS	P21.35				
C1	COUNCIL REQUIREMENTS	15-01-18	J.B.	ELECTRICITY CABLE	DRAINAGE PIT STAGE/NUMBER	721.35				
P1	PRELIMINARY ISSUE	20-10-2017	L.P.	TELECOMMUNICATIONS CABLE	EX./FUT. INLET, DRAINAGE PITS	P21.35				
				WATER CONDUIT	EX./FUT. INLET, DRAINAGE PITS	P21.35				
				GAS CONDUIT	EX./FUT. INLET, DRAINAGE PITS	P21.35				
				RECYCLED WATER CONDUIT	EX./FUT. INLET, DRAINAGE PITS	P21.35				
				COMBINED SERVICES CONDUIT	EX./FUT. INLET, DRAINAGE PITS	P21.35				
				T.B.M.	EX./FUT. INLET, DRAINAGE PITS	P21.35				
				P.S.M.	EX./FUT. INLET, DRAINAGE PITS	P21.35				
				STREET SIGN	EX./FUT. INLET, DRAINAGE PITS	P21.35				

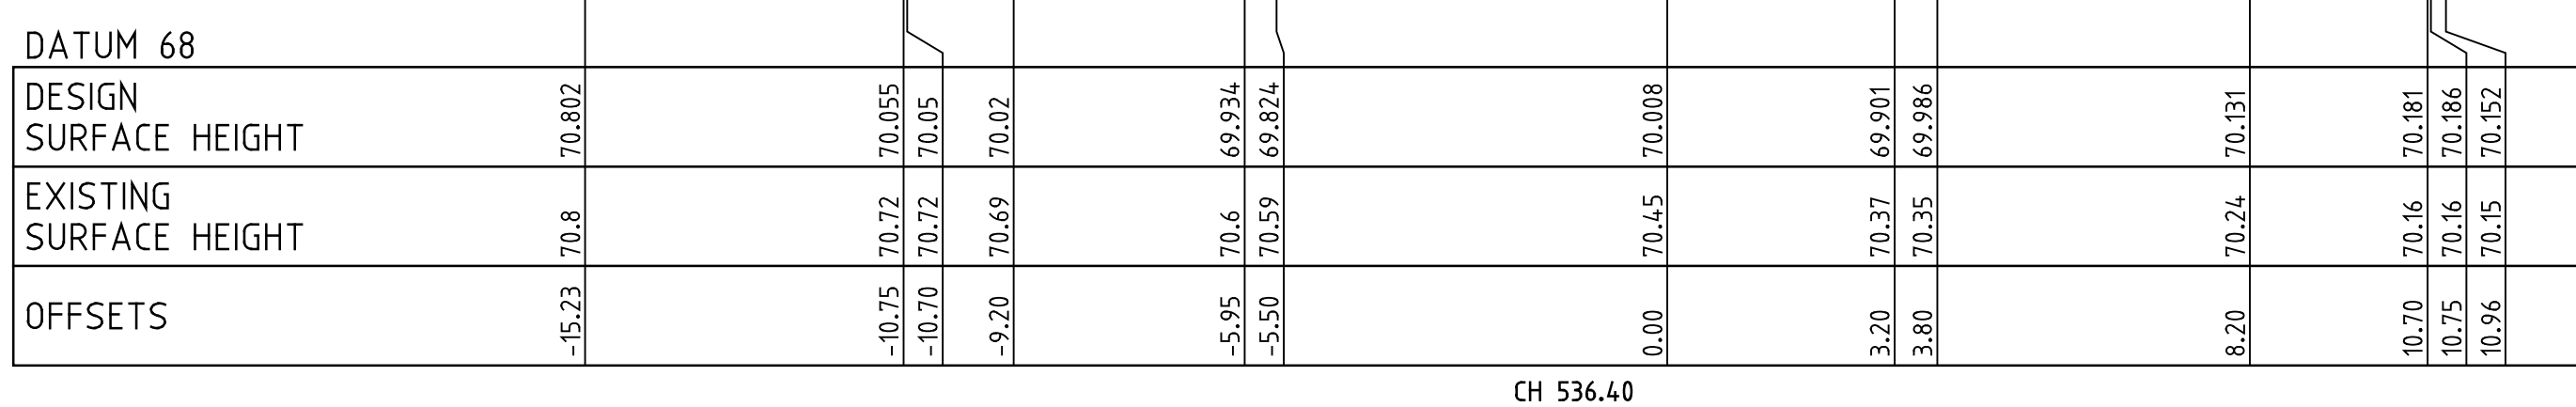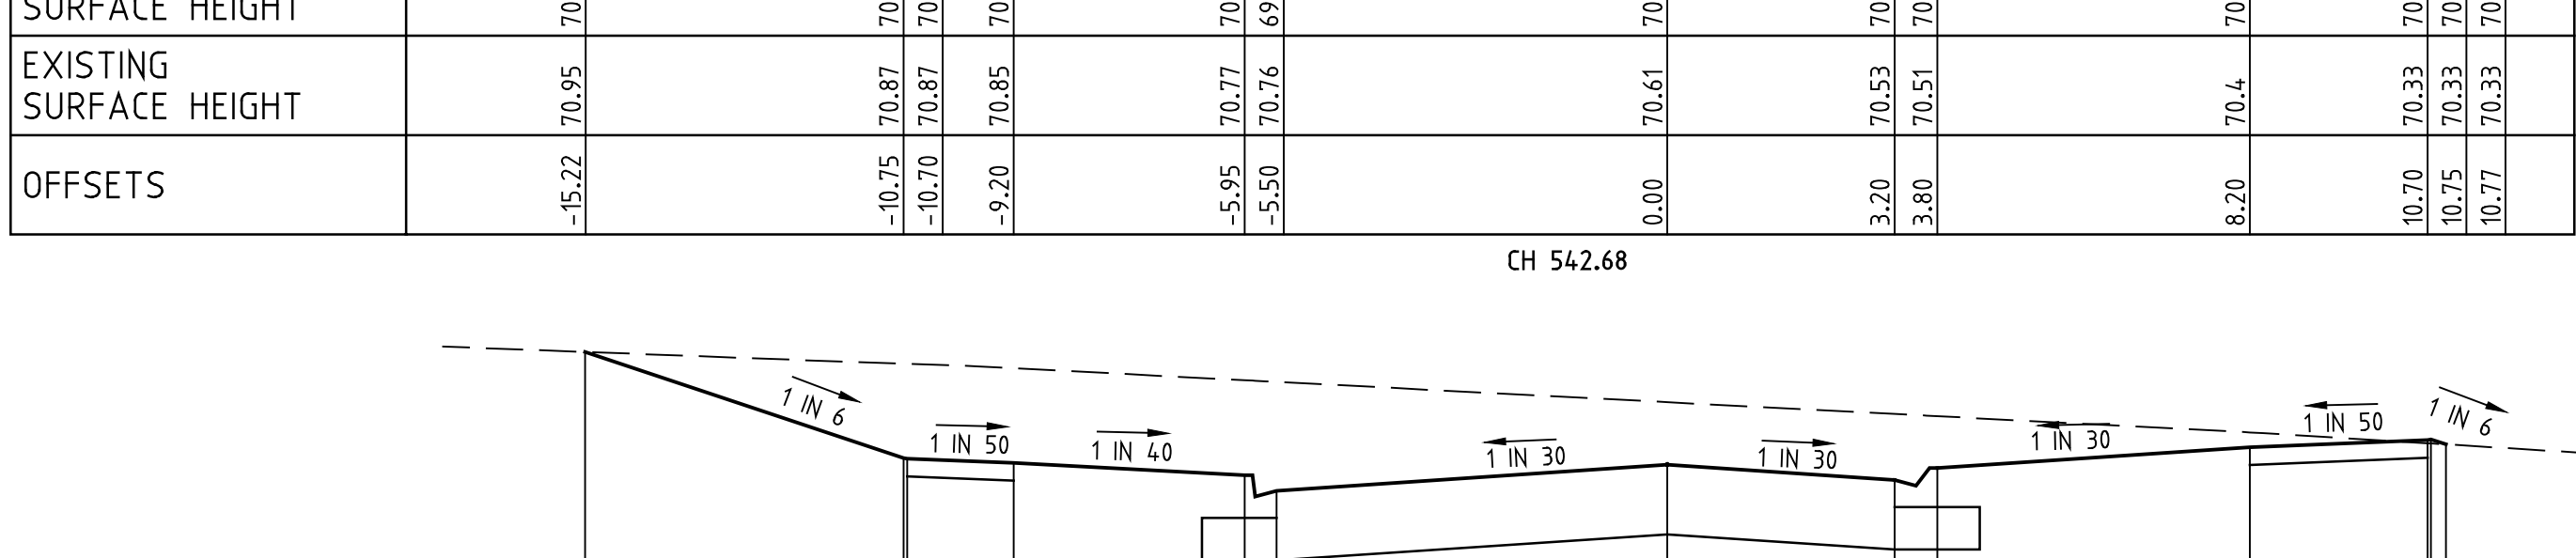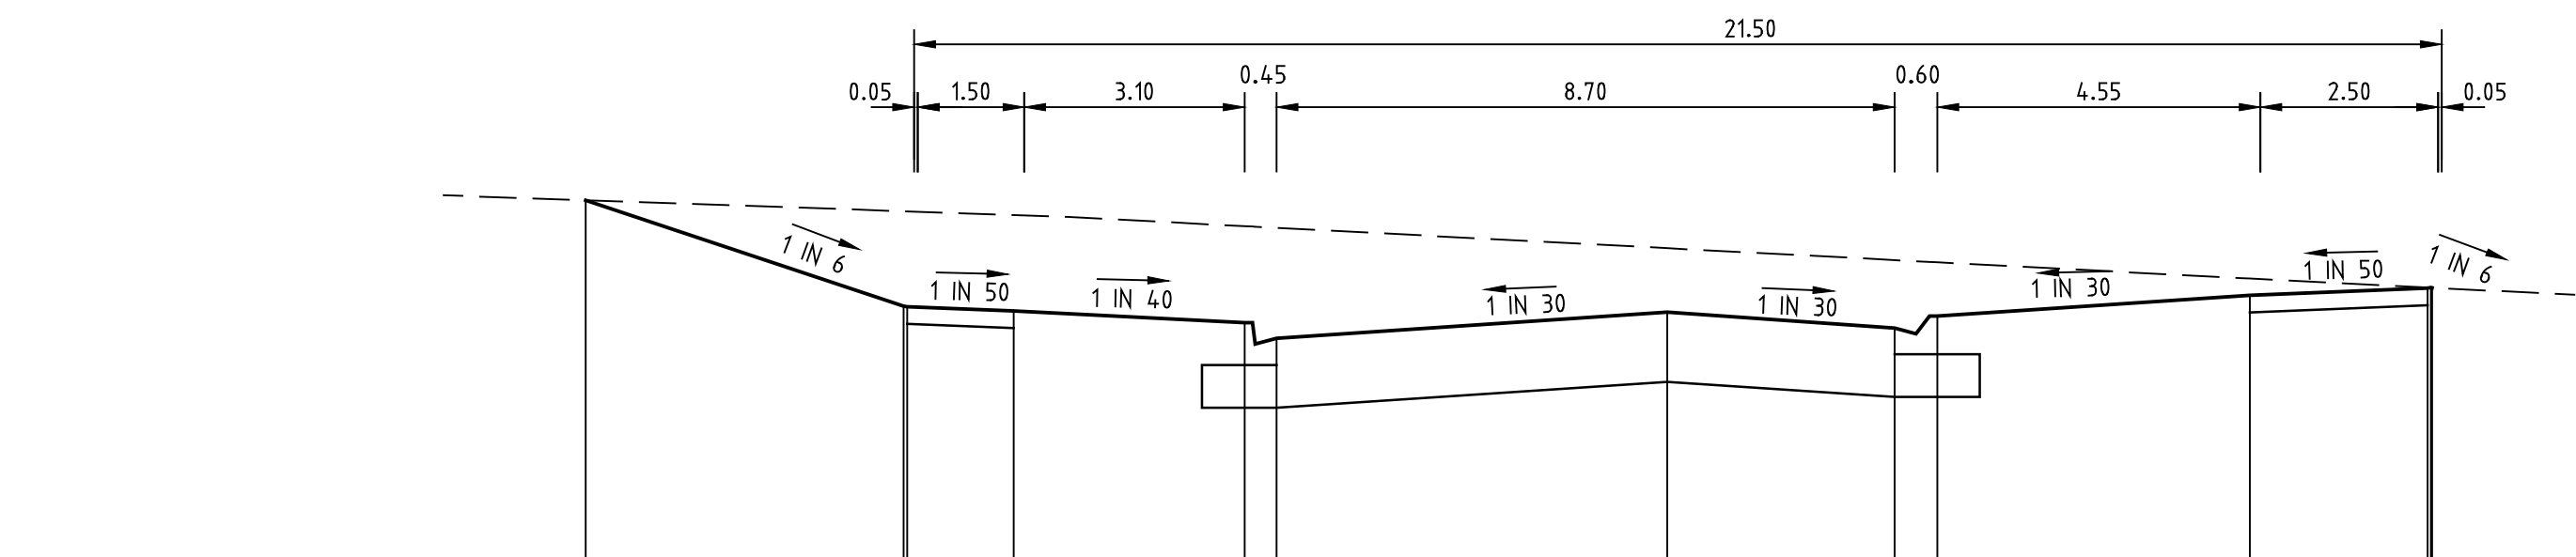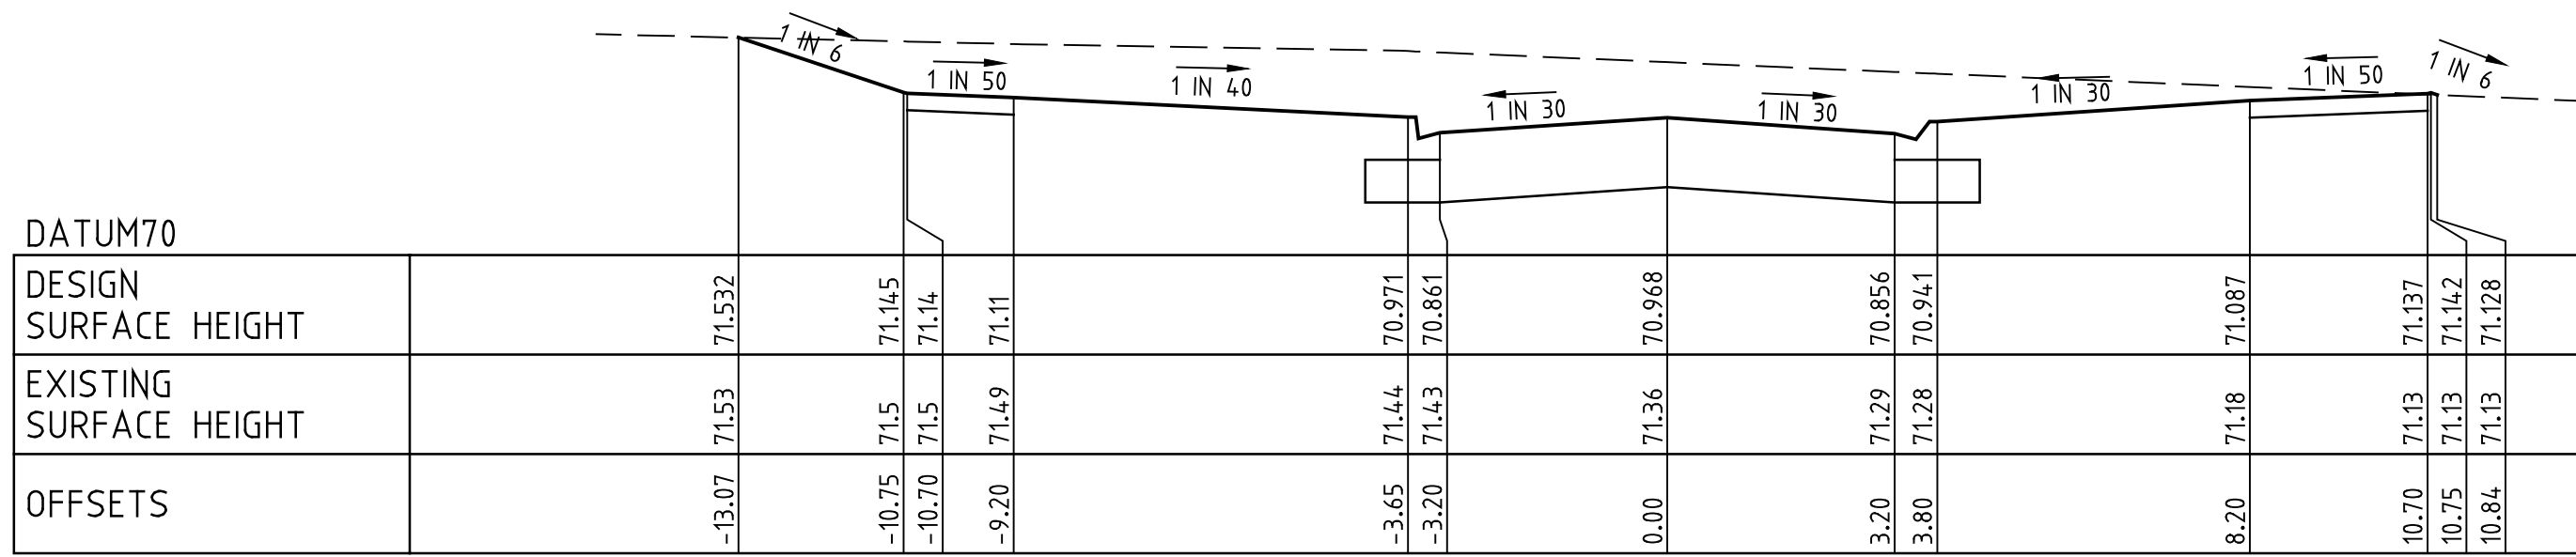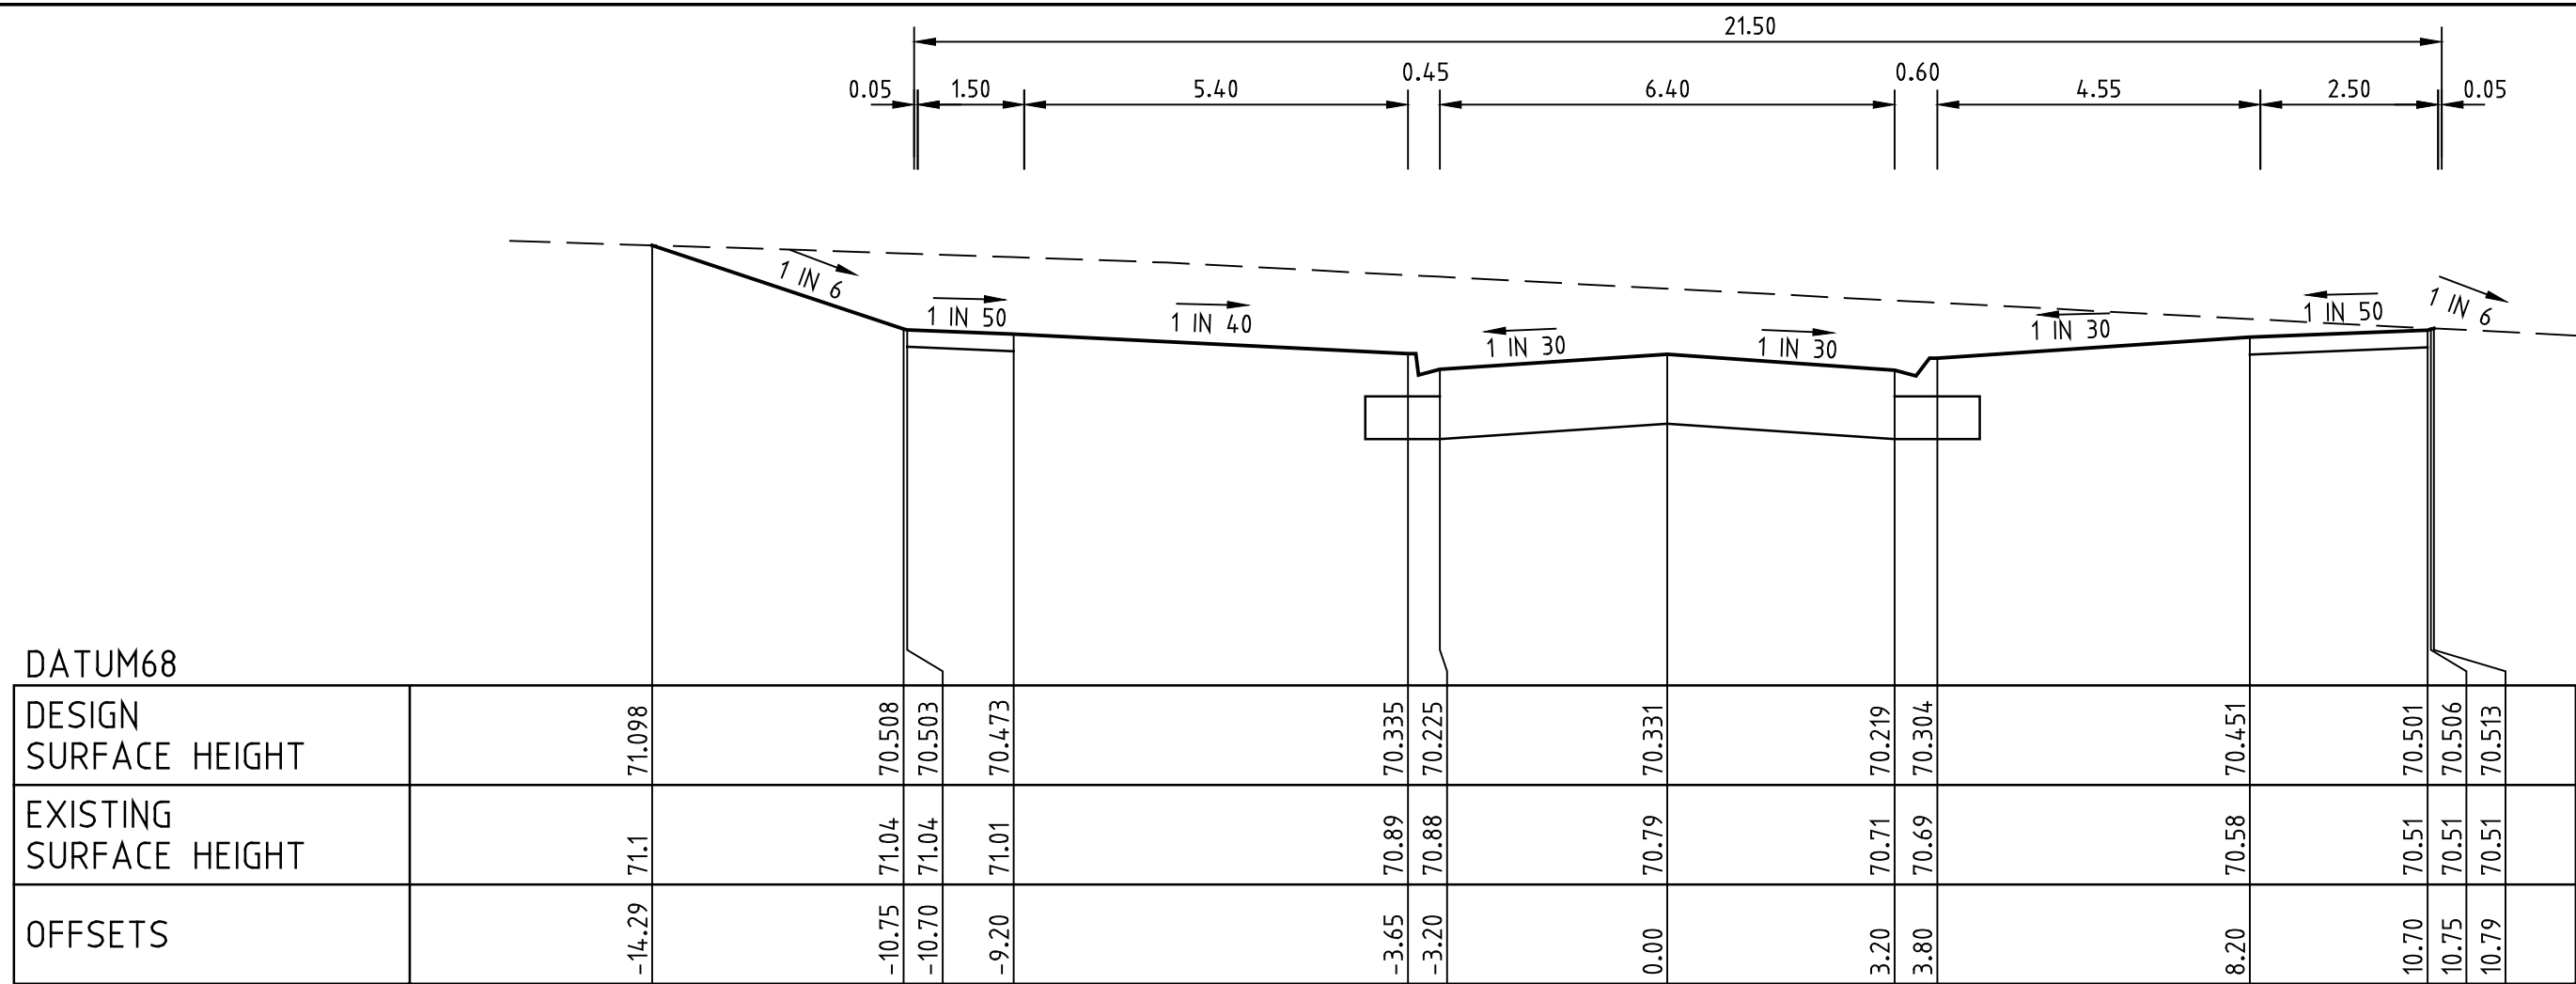

ROAD CROSS SECTIONS DOMINION DRIVE


SCALES HOR 1 : 100 VER 1 : 50

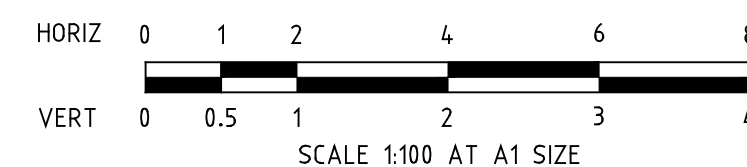

AS CONSTRUCTED

REV.	REVISION	DATE	APPD.	LEGEND
-	-	-	-	
C2	AS CONSTRUCTED ISSUE	10-4-19	J.B.	
C1	COUNCIL REQUIREMENTS	15-01-18	J.B.	
P1	PRELIMINARY ISSUE	20-10-17	L.P.	


22 Business Park Drive Notting Hill 3168
A.C.N. 006 550 803
E: consulting@dpmvic.com.au
W: www.dpmvic.com.au
T: (03) 9538 5000

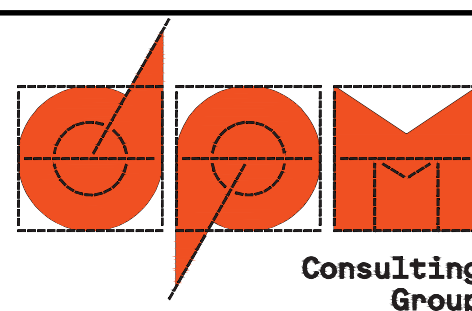

DRAWN: J.BEVERIDGE
DESIGNED: J.BEVERIDGE
CHECKED: L.PAPAZOIS
AUTHORISED: T.DAVOLI
DATE: 20-10-2017


AUTHORITY: CITY OF MELTON
PROJECT: MODEINA
STAGE 18
DETAILS: DOMINION DRIVE - CROSS SECTIONS

SCALE AS SHOWN
LEVEL DATUM AHD
SHEET 8 OF 13
DRAWING No. 1275/NE/18/08
REV. C2

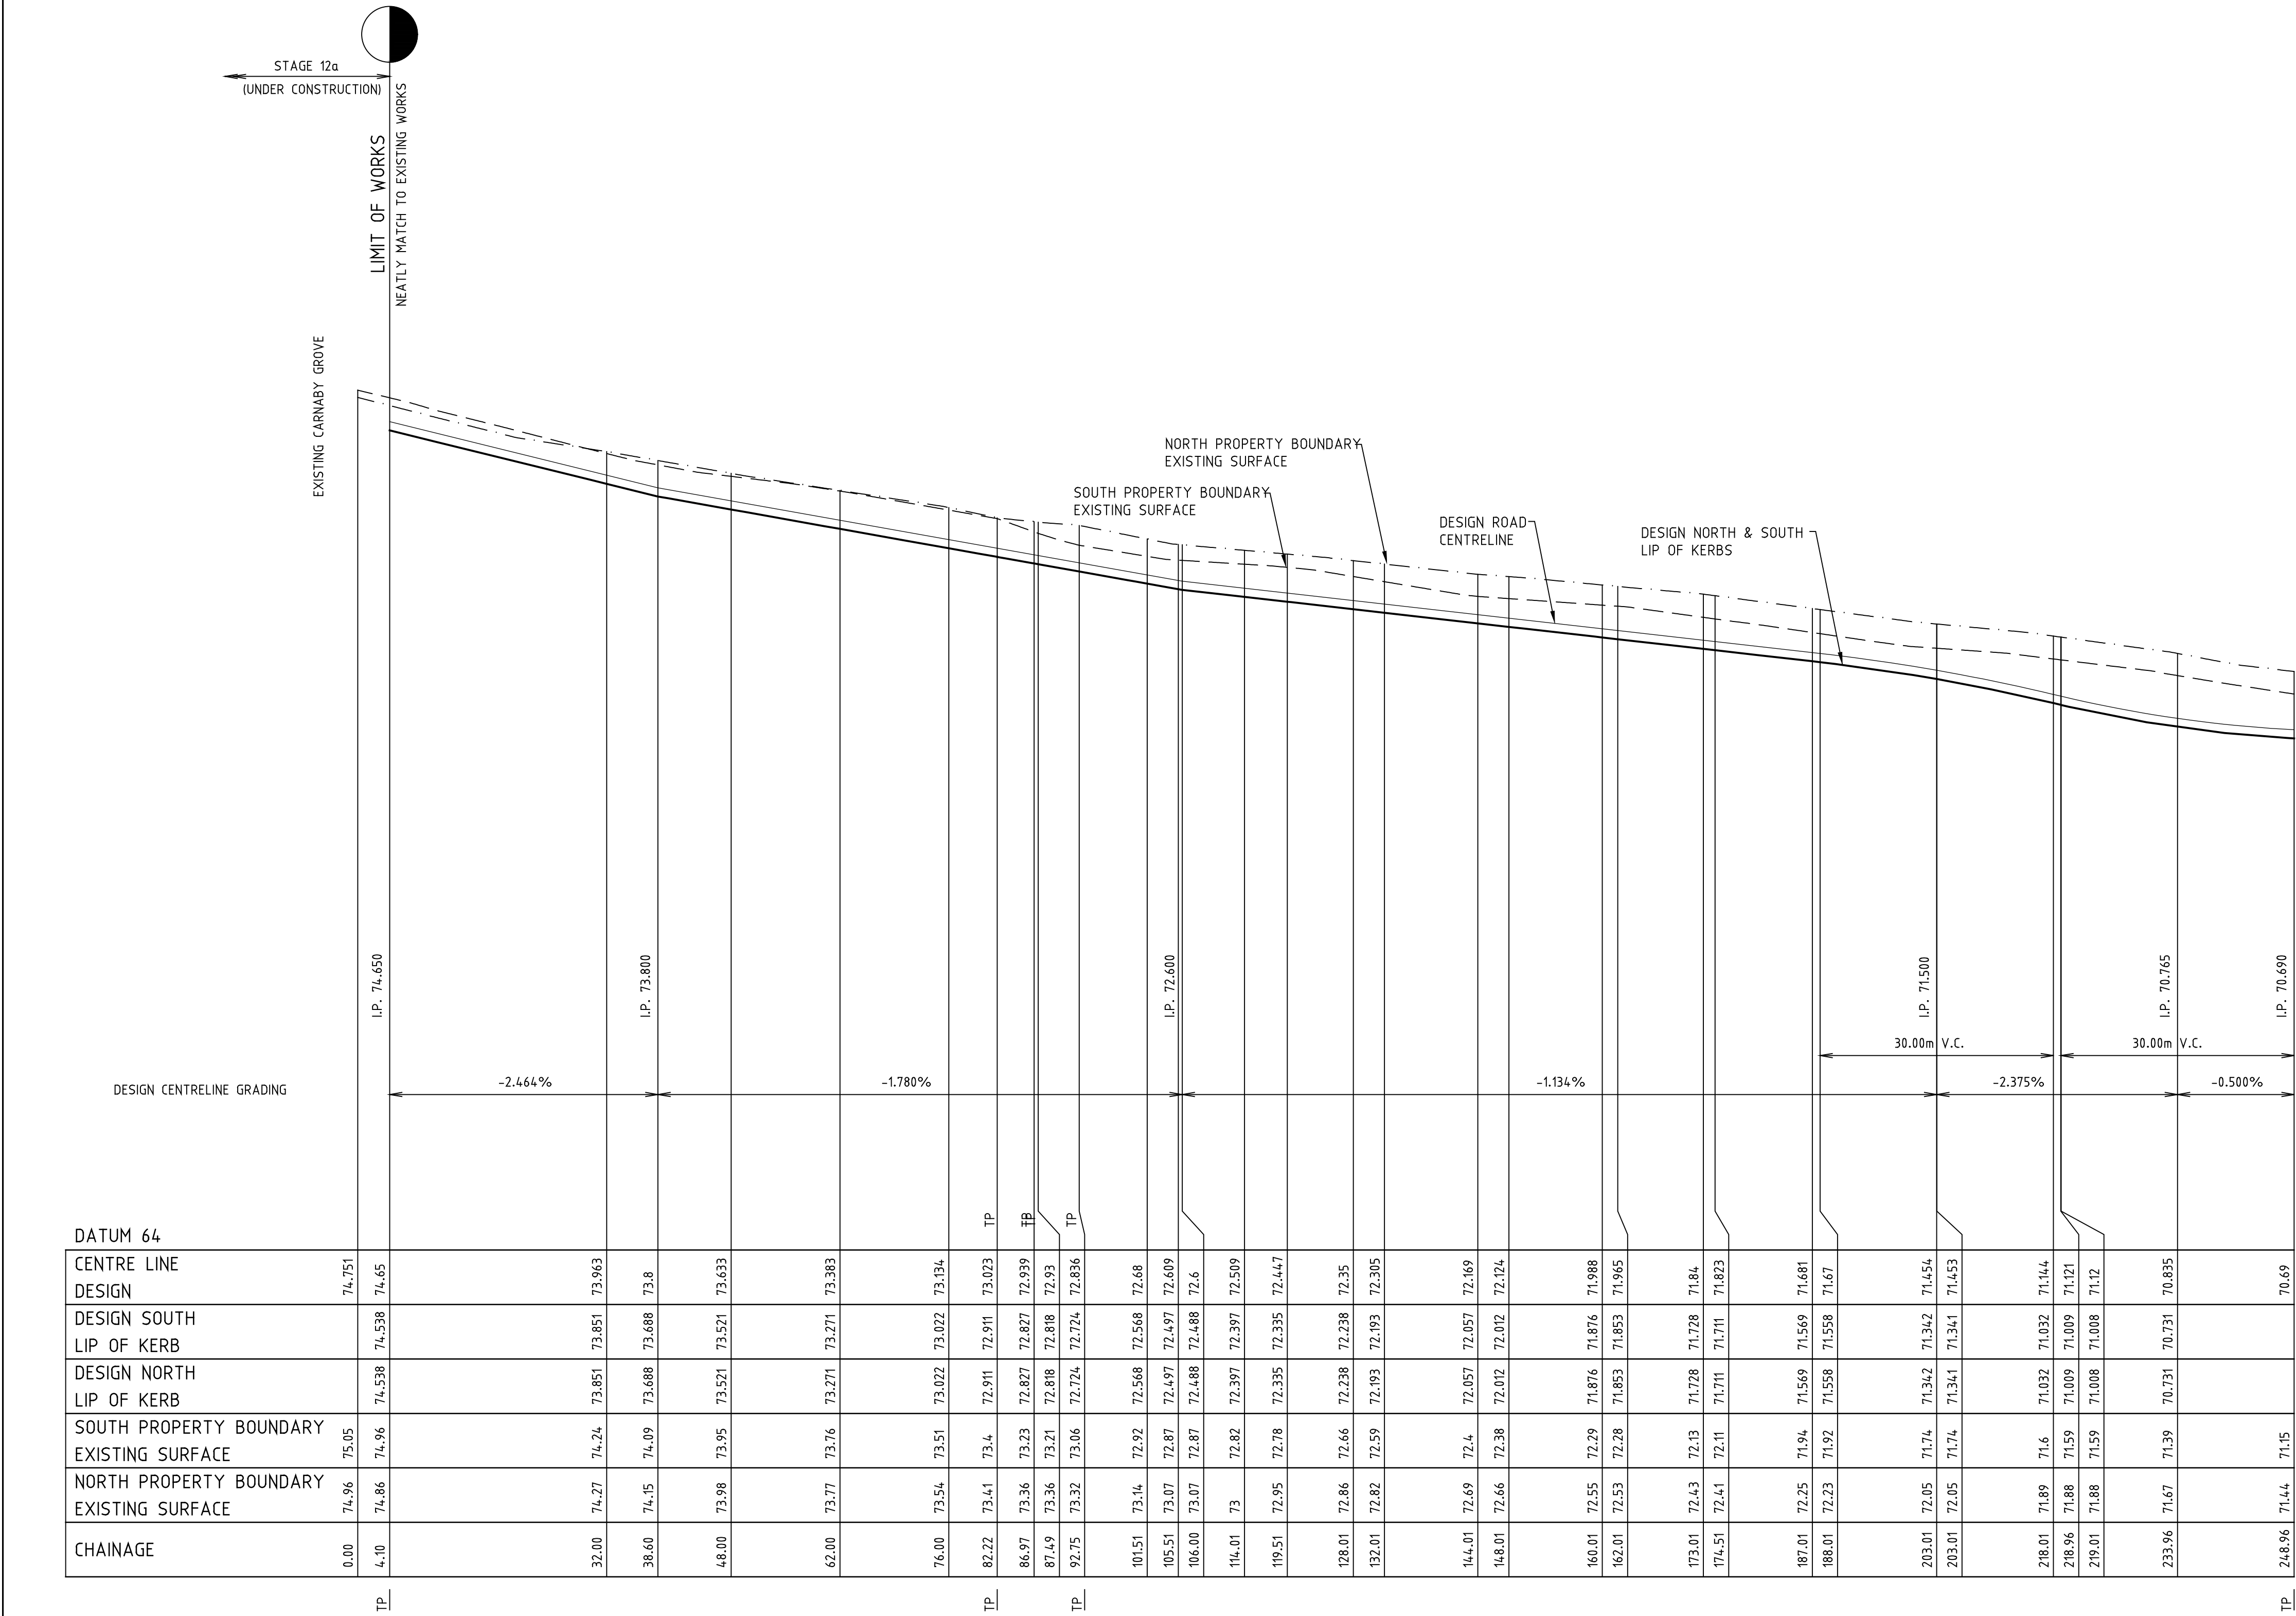







ROAD LONGITUDINAL EMPIRE AVENUE



SCALES HOR 1 : 500 VER 1 : 50

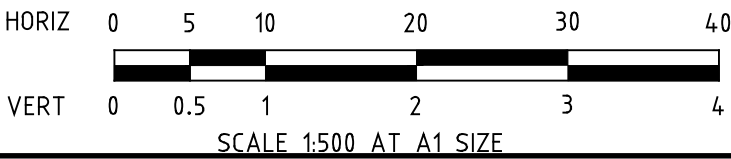

AS CONSTRUCTED

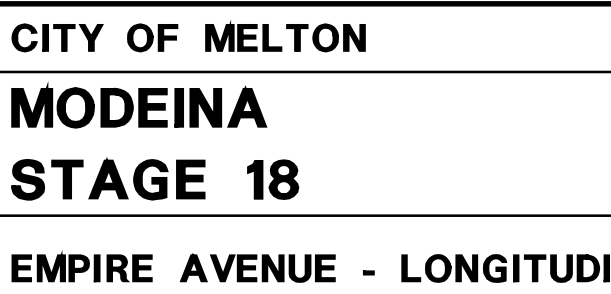
				LEGEND					22 Business Park Drive Notting Hill 3168 A.C.N. 006 550 803 E: consulting@dpmvic.com.au W: www.dpmvic.com.au T: (03) 9538 5000			DRAWN: J.BEVERIDGE	AUTHORITY: CITY OF MELTON	SCALE AS SHOWN
									DESIGNED: J.BEVERIDGE	PROJECT: MODEINA STAGE 18		LEVEL DATUM AHD		
C2	AS CONSTRUCTED ISSUE	10-4-19	J.B.						CHECKED: L.PAPAZOIS			SHEET 9 OF 13		
C1	COUNCIL REQUIREMENTS	15-01-18	J.B.						AUTHORISED: T.DAVOLI	DETAILS: EMPIRE AVENUE - LONGITUDINAL SECTION		DRAWING No. 1275/18/NE/09	REV. C2	
P1	PRELIMINARY ISSUE	20-10-17	L.P.						DATE: 20-10-2017					
REV.	REVISION	DATE	APPD.											
					GAS MAIN		HOUSE DRAIN PROPOSED/EX.		CHAINAGES AND TANGENT POINTS					
					WATER MAIN		PROPERTY INLET, DRAINAGE PITS		EXISTING SURFACE LEVEL					
					RECYCLED WATER MAIN		EX./FUT. INLET, DRAINAGE PITS		FINISHED LEVEL (TITLE BOUNDARY)					
					ELECTRICITY CABLE		DRAINAGE PIT STAGE/NUMBER		DESIGN TOP/TOP OF BATTER LEVEL					
					TELECOMMUNICATIONS CABLE		SEWER LINE AND STRUCTURES		DESIGN PAVEMENT LEVEL					
					WATER CONDUIT		EX./FUT. KERB AND STRUCTURES		PROPOSED CONTOUR LINE & LEVEL					
					GAS CONDUIT		KERB AND CHANNEL		EXISTING CONTOUR LINE & LEVEL					
					RECYCLED WATER CONDUIT		EX./FUT. KERB AND CHANNEL		FILLING IN EXCESS OF 200mm					
					COMBINED SERVICES CONDUIT		KERB TO BE REMOVED OFFSITE		CATCH DRAIN AND INVERT LEVEL					
					T.B.M.		P.S.M.		EX. BATTER					
					STREET SIGN		PROP. BATTER							

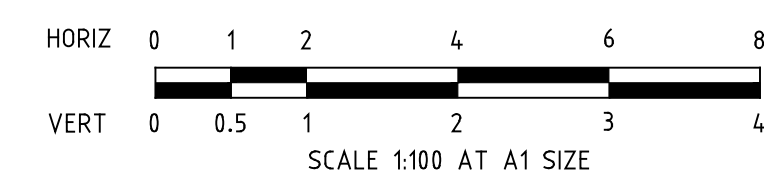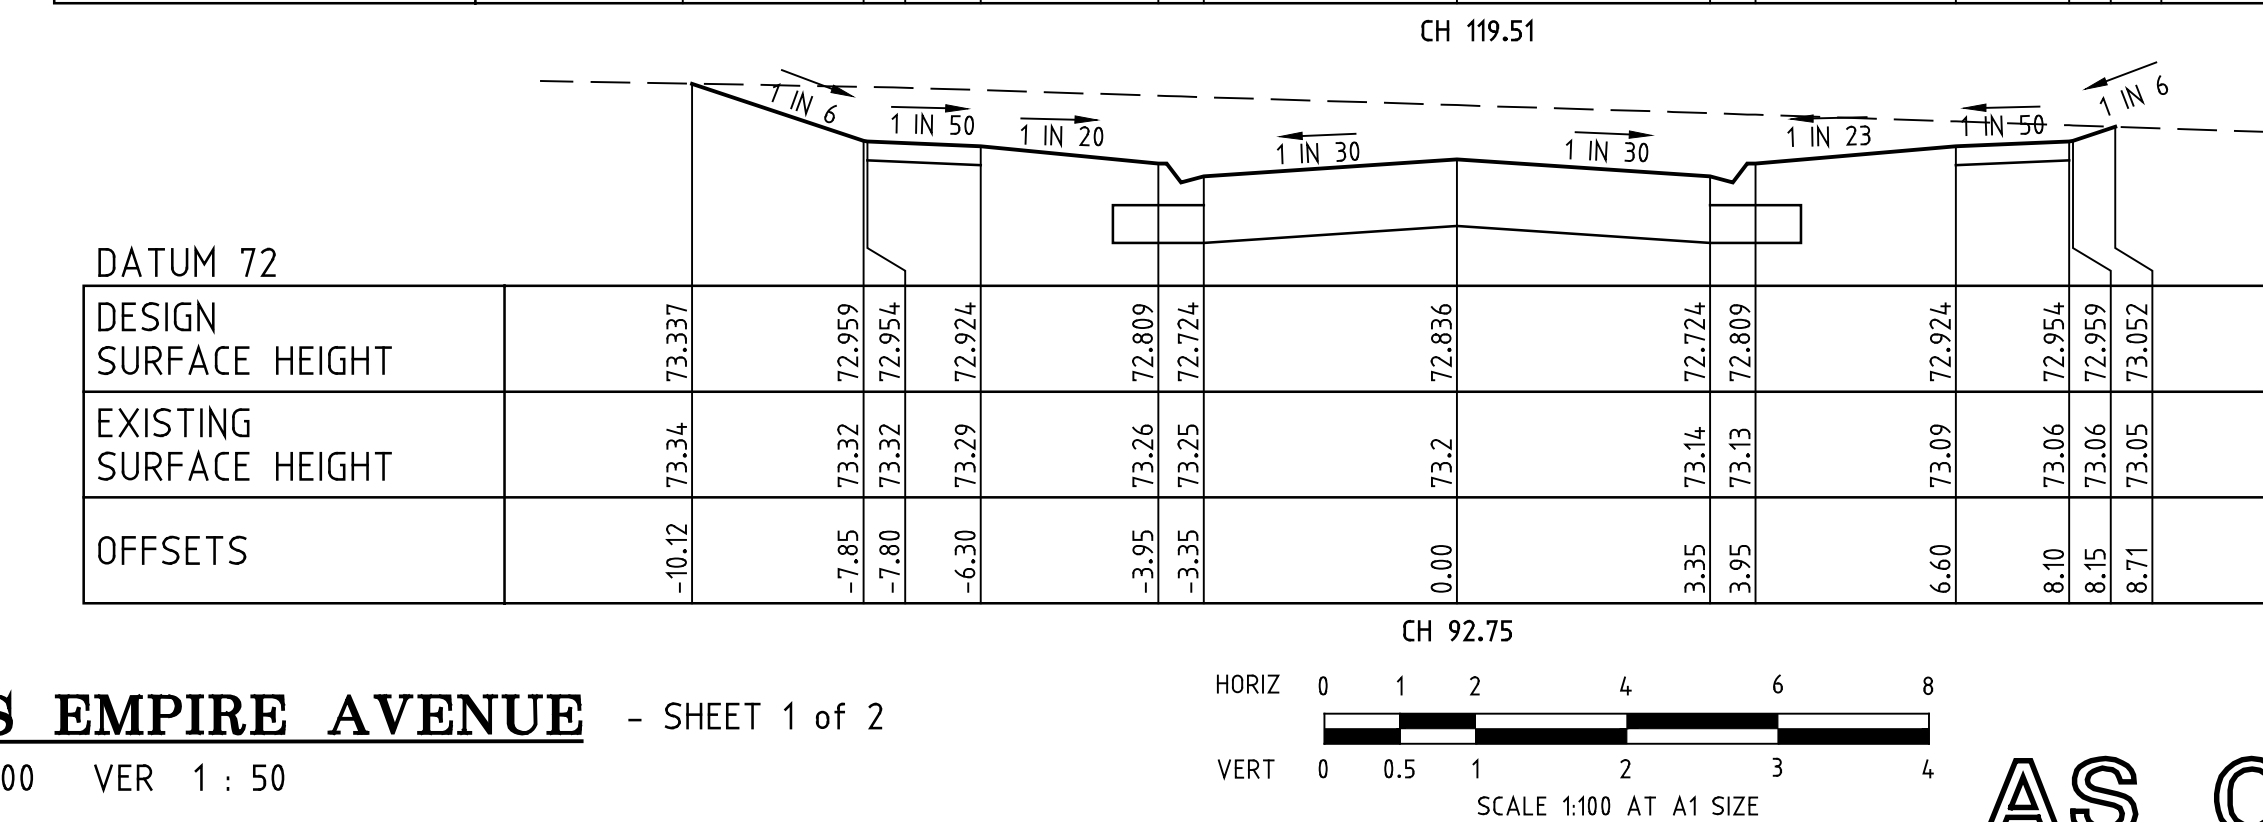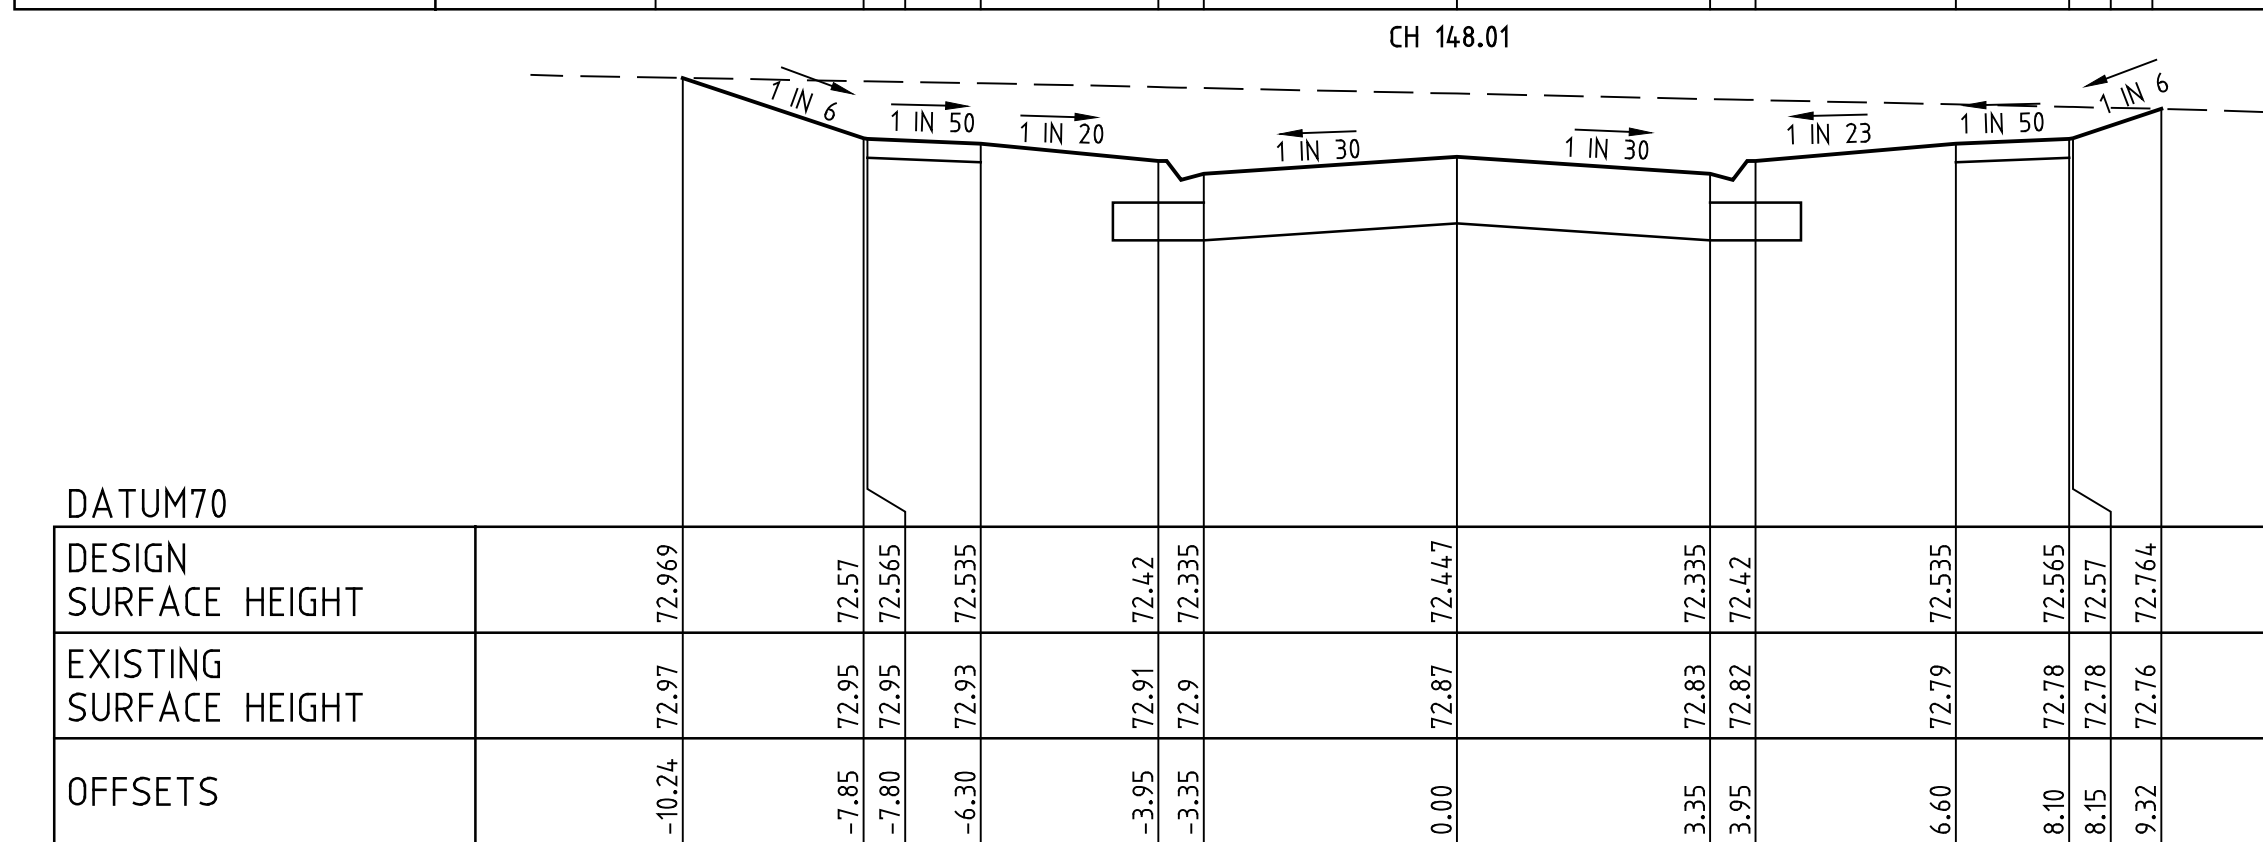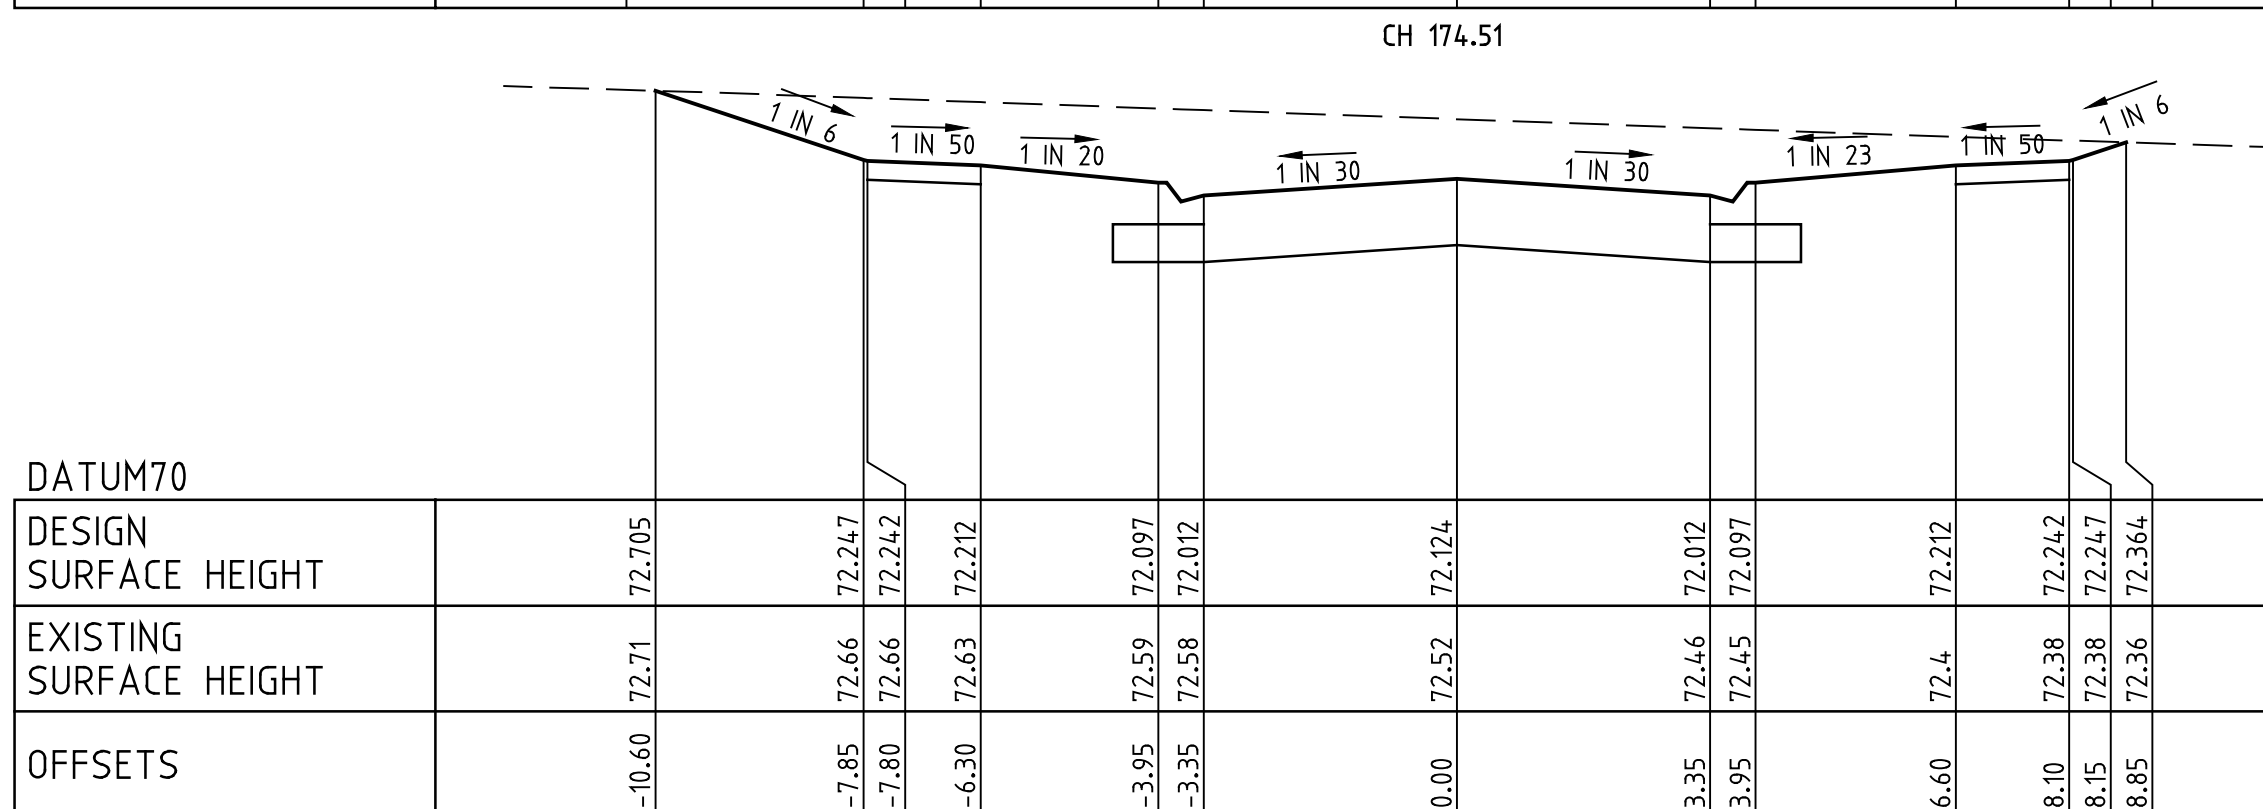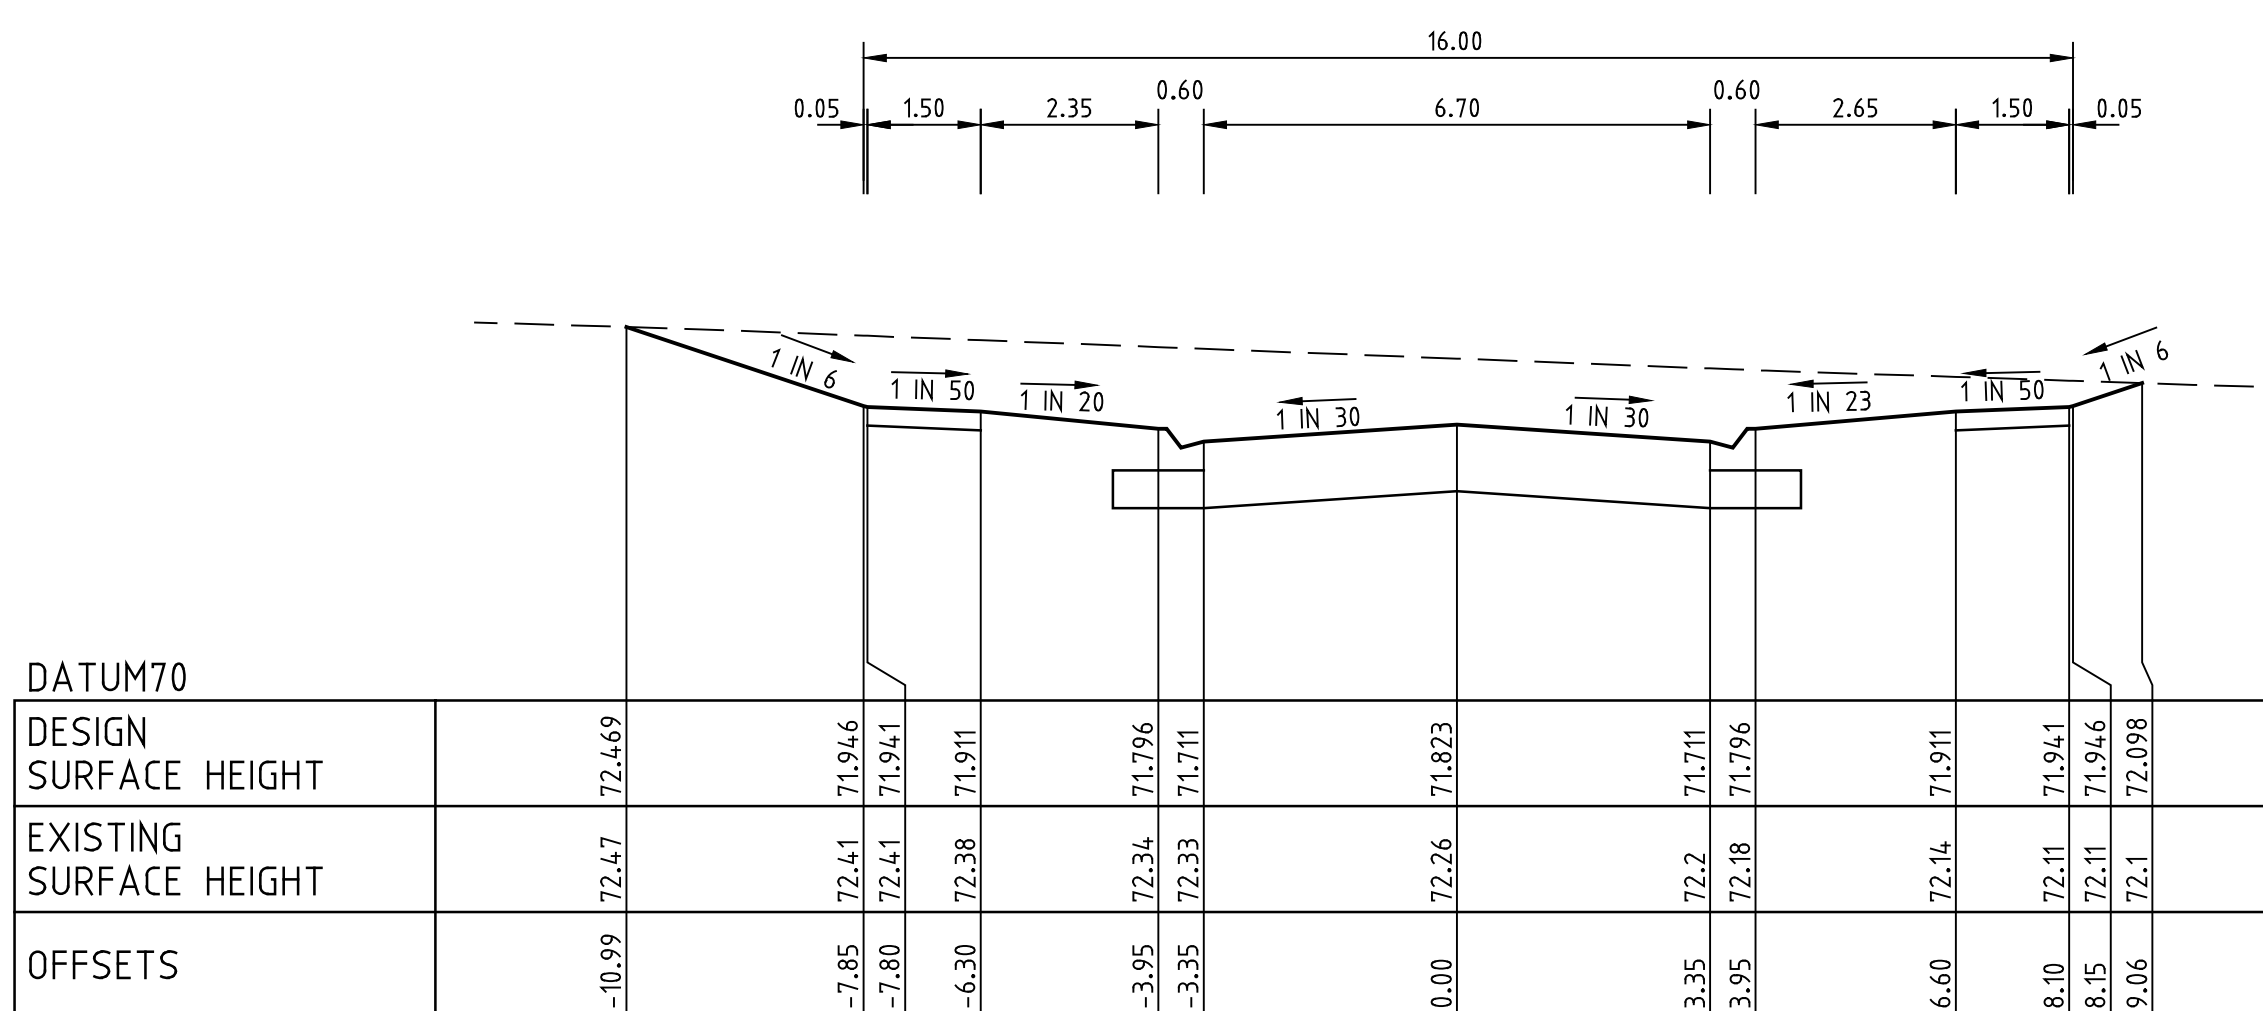[illegible]

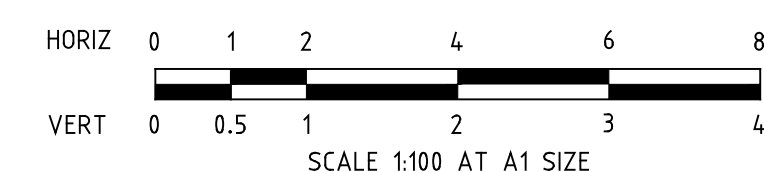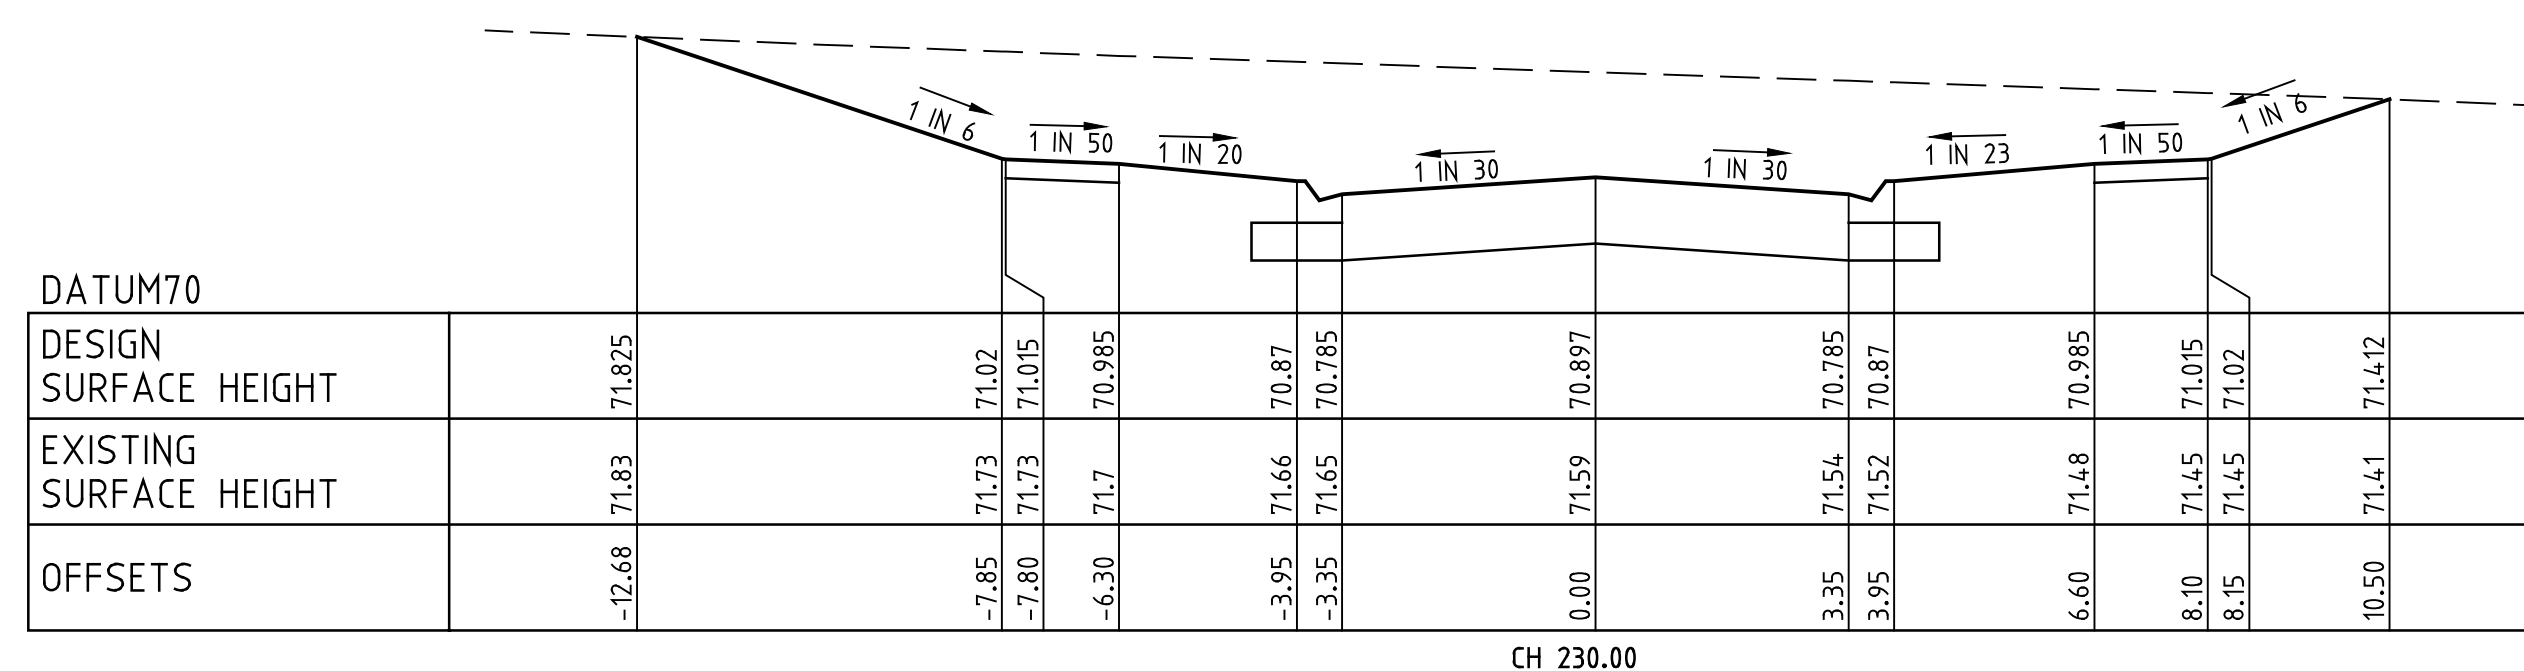

AS CONSTRUCTED


[illegible]

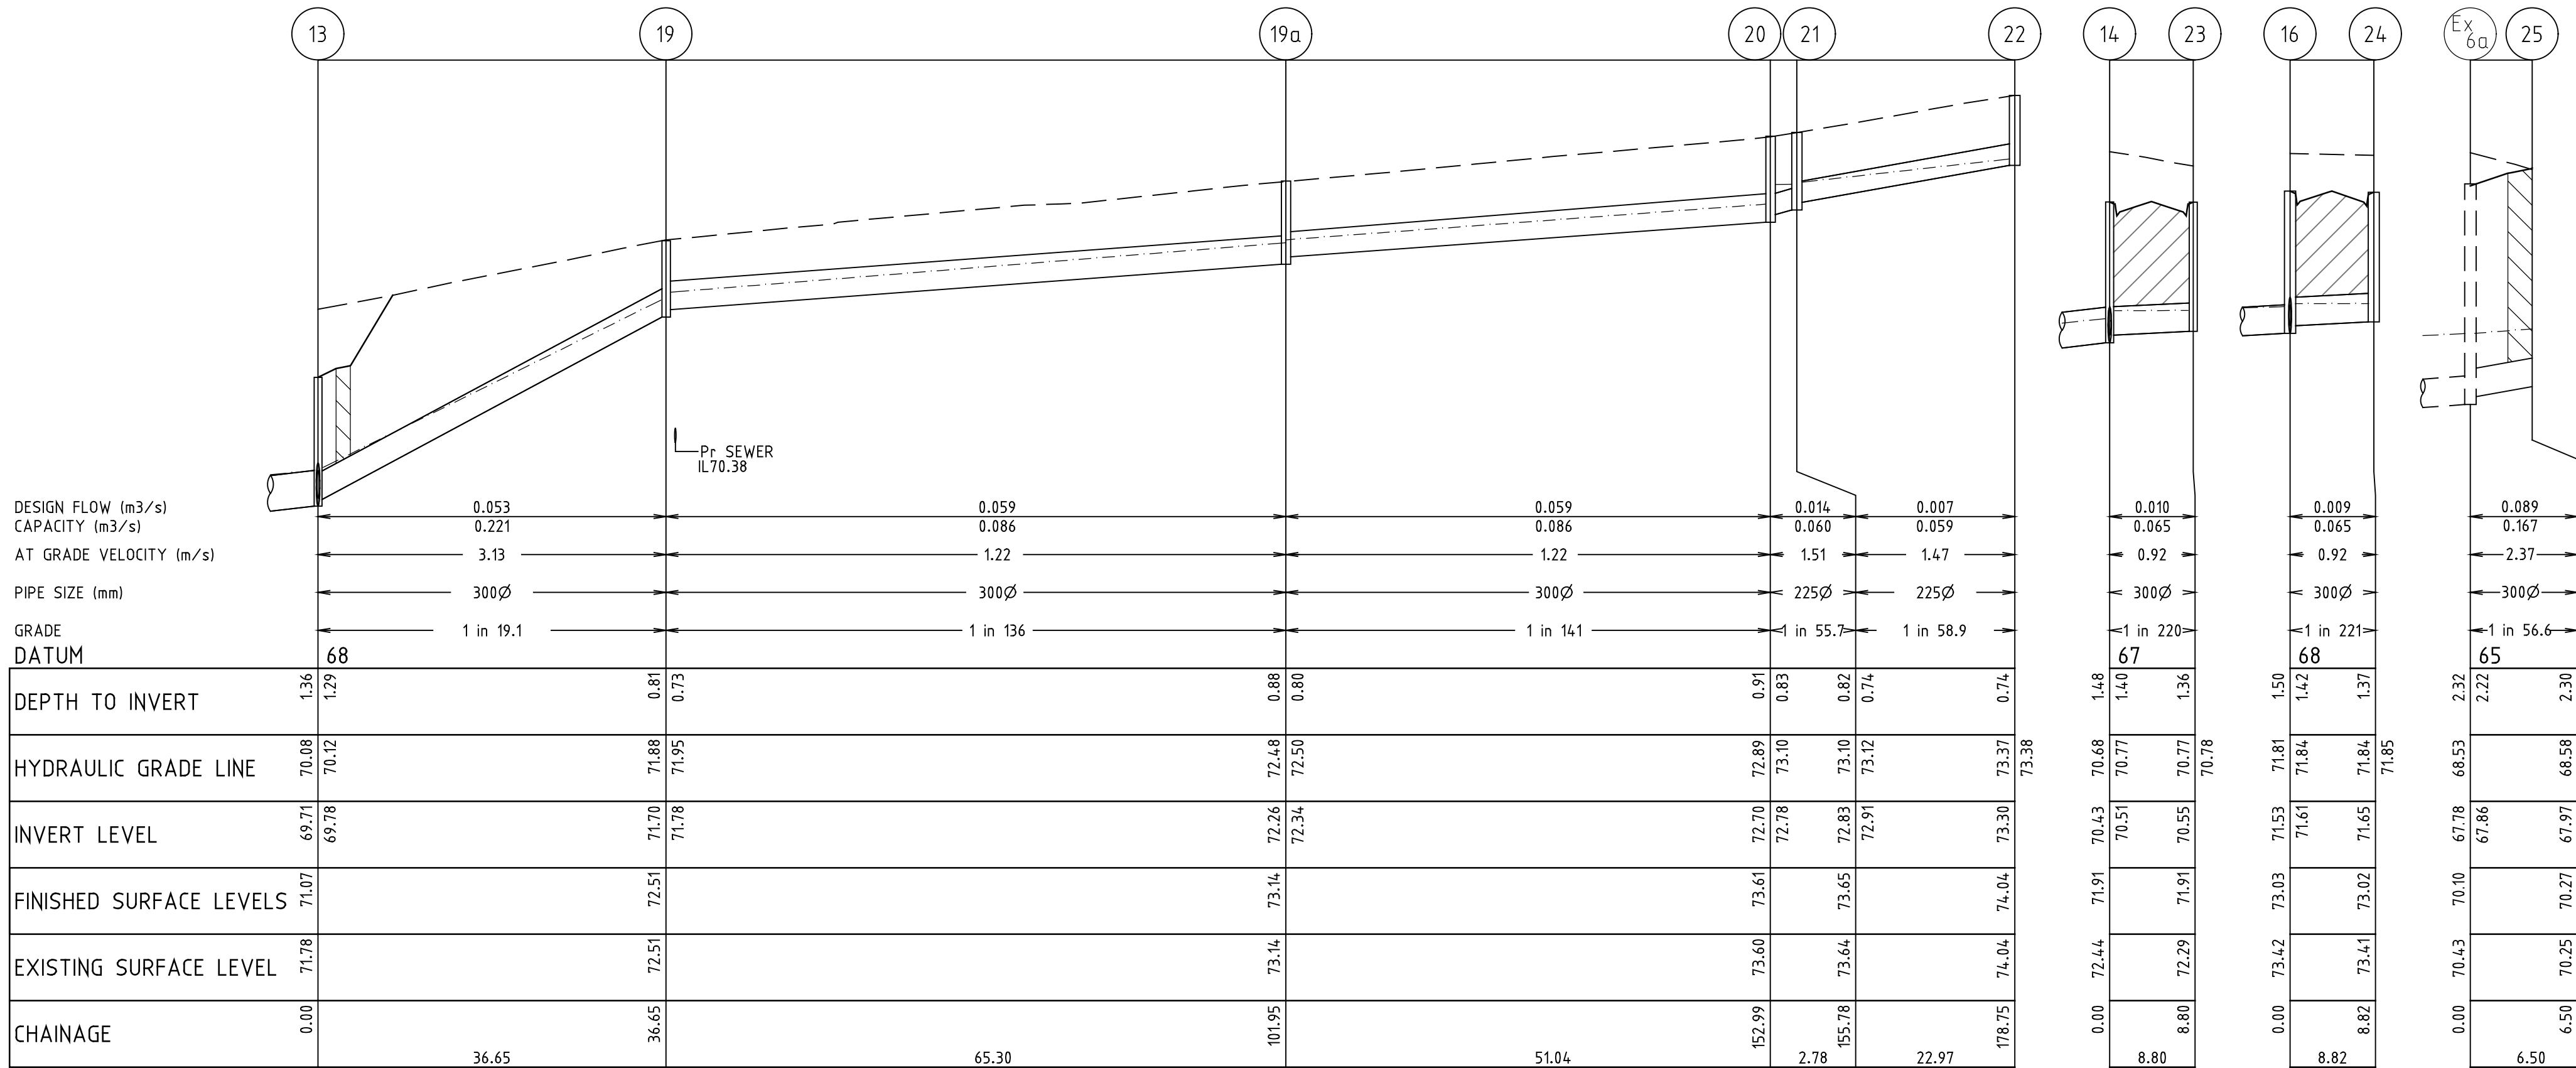

PIT SCHEDULE											
PIT No.	TYPE	INTERNAL		INLET		OUTLET		F.S.L.	PIT DEPTH	REMARKS	
		WID.	LEN.	DIA.	INV. R.L.	DIA.	INV. R.L.				
1	ExEP	-	-	750	67.58	750	67.58	70.03	2.45	CONNECT TO EXISTING END OF PIPE	
2	JP	1050	900	750	68.26	300	67.69	70.18	2.49	REFER EDM 605 & 607. SHAFT TO BE 600mm X 900mm	
3	SEP	1050	600	750	68.62	750	68.59	70.69	2.10	REFER EDM 603 & 607. SHAFT TO BE 600mm X 900mm	
4	SEP	1050	600	750	68.85	750	68.82	70.69	1.87	REFER EDM 603 & 607. SHAFT TO BE 600mm X 900mm	
5	SEP	1050	900	375	69.40	750	69.07	70.99	1.92	REFER EDM 603 & 607. SHAFT TO BE 600mm X 900mm	
5a	EP	-	-	300	69.55	-	-	71.57	2.16	PROVIDE BLANK END	
11	JP	900	600	-	-	300	69.66	71.04	1.39	REFER EDM 601.	
13	JP	600	900	375	69.79	375	69.71	71.07	1.36	REFER EDM 605.	
14	SEP	600	900	300	70.51	375	70.43	71.91	1.48	REFER EDM 603.	
15	JP	600	900	300	71.49	300	71.41	72.82	1.41	REFER EDM 605.	
16	SEP	600	900	300	71.61	300	71.53	73.03	1.50	REFER EDM 603.	
17	JP	600	900	225	72.81	300	72.73	74.01	1.28	REFER EDM 605.	
17a	EP	-	-	-	-	225	73.93	74.30	0.91	PROVIDE BLANK END	
19	JP	900	600	300	71.78	300	71.70	72.51	0.81	REFER EDM 605.	
19a	JP	900	600	300	72.34	300	72.26	73.14	0.88	REFER EDM 605.	
20	JP	600	900	225	72.78	300	72.70	73.61	0.91	REFER EDM 605.	
21	JP	600	900	225	72.91	225	72.83	73.65	0.82	REFER EDM 605.	
22	JP	600	900	-	-	225	73.30	74.04	0.74	REFER EDM 605.	
23	SEP	900	600	-	-	300	71.91	71.91	1.36	REFER EDM 603.	
24	SEP	900	600	-	-	300	71.65	73.02	1.37	REFER EDM 603.	
Ex6a	ExJP	600	900	300	67.86	Ex300	67.78	70.10	2.32	BREAK INTO EXISTING PIT & REINSTATE TO COUNCIL SATISFACTION.	
25	EP	-	-	-	-	300	67.97	70.27	2.30	PROVIDE BLANK END	

NOTATION:
JP = JUNCTION PIT
SEP = SIDE ENTRY PIT
EP = END OF PIPE
WIDTH OF PIT IS MEASURED AT THE OUTLET

INDICATES CLASS 2 CRUSHED ROCK BACKFILL
INDICATES CLASS 3 CRUSHED ROCK BACKFILL

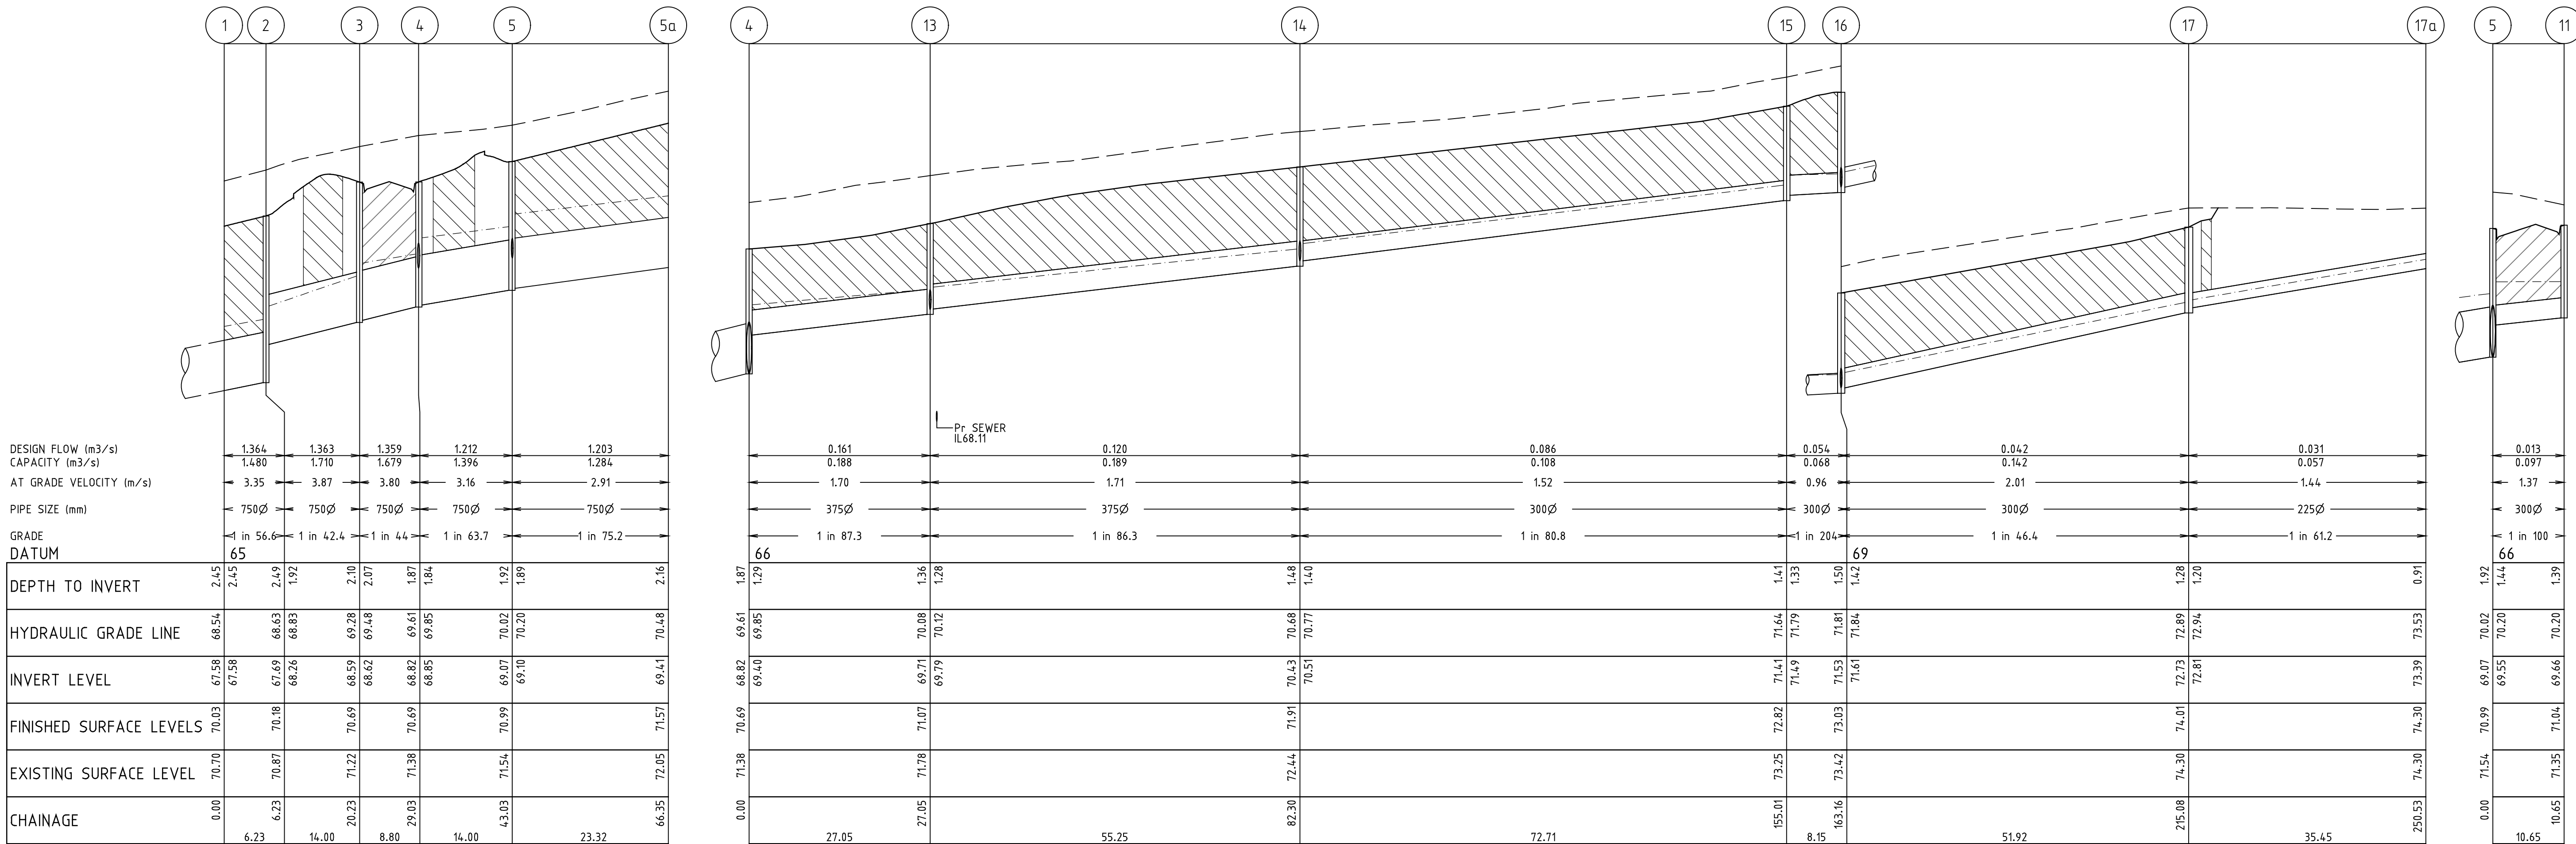

AS CONSTRUCTED

C5	AS CONSTRUCTED ISSUE	10-4-19	J.B.
C4	MINOR AMENDMENTS	25-6-18	J.B.
C3	MINOR AMENDMENTS	12-2-18	J.B.
C2	COUNCIL REQUIREMENTS	5-2-18	J.B.
C1	COUNCIL REQUIREMENTS	15-01-18	J.B.
P1	PRELIMINARY ISSUE	20-10-17	L.P.
REV.	REVISION	DATE	APPD.

	GAS MAIN
	WATER MAIN
	RECYCLED WATER MAIN
	ELECTRICITY CABLE
	TELECOMMUNICATIONS CABLE
	WATER CONDUIT
	GAS CONDUIT
	RECYCLED WATER CONDUIT
	COMBINED SERVICES CONDUIT
	T.B.M.
	P.S.M.

	HOUSE DRAIN PROPOSED/EX.
	PROPERTY INLET, DRAINAGE PITS
	EX./FUT. INLET, DRAINAGE PITS
	DRAINAGE PIT STAGE/NUMBER
	SEWER LINE AND STRUCTURES
	EX./FUT. LINE AND STRUCTURES
	KERB AND CHANNEL
	EX./FUT. KERB AND CHANNEL
	KERB TO BE REMOVED OFFSITE
	STREET SIGN


	CHAINS AND TANGENT POINTS
	EXISTING SURFACE LEVEL
	FINISHED LEVEL (TITLE BOUNDARY)
	DESIGN TOP/TOP OF BATTER LEVEL
	DESIGN PAVEMENT LEVEL
	PROPOSED CONTOUR LINE & LEVEL
	EXISTING CONTOUR LINE & LEVEL
	FILLING IN EXCESS OF 200mm
	CATCH DRAIN AND INVERT LEVEL
	EX. BATTER
	PROP. BATTER

22 Business Park Drive Notting Hill 3168
A.C.N. 006 550 803
E: consulting@dpmvic.com.au
W: www.dpmvic.com.au
T: (03) 9538 5000

DRAWN: J.BEVERIDGE
DESIGNED: J.BEVERIDGE
CHECKED: L.PAPAZOIS
AUTHORISED: T.DAVOLI
DATE: 20-10-2017

AUTHORITY: CITY OF MELTON
PROJECT: MODEINA STAGE 18
DETAILS: DRAINAGE LONGITUDINAL SECTIONS & PIT SCHEDULE

SCALE 1:500 H, 1:50V
LEVEL DATUM AHD
SHEET 12 OF 13
DRAWING No. 1275/18/NE/12
REV. C5

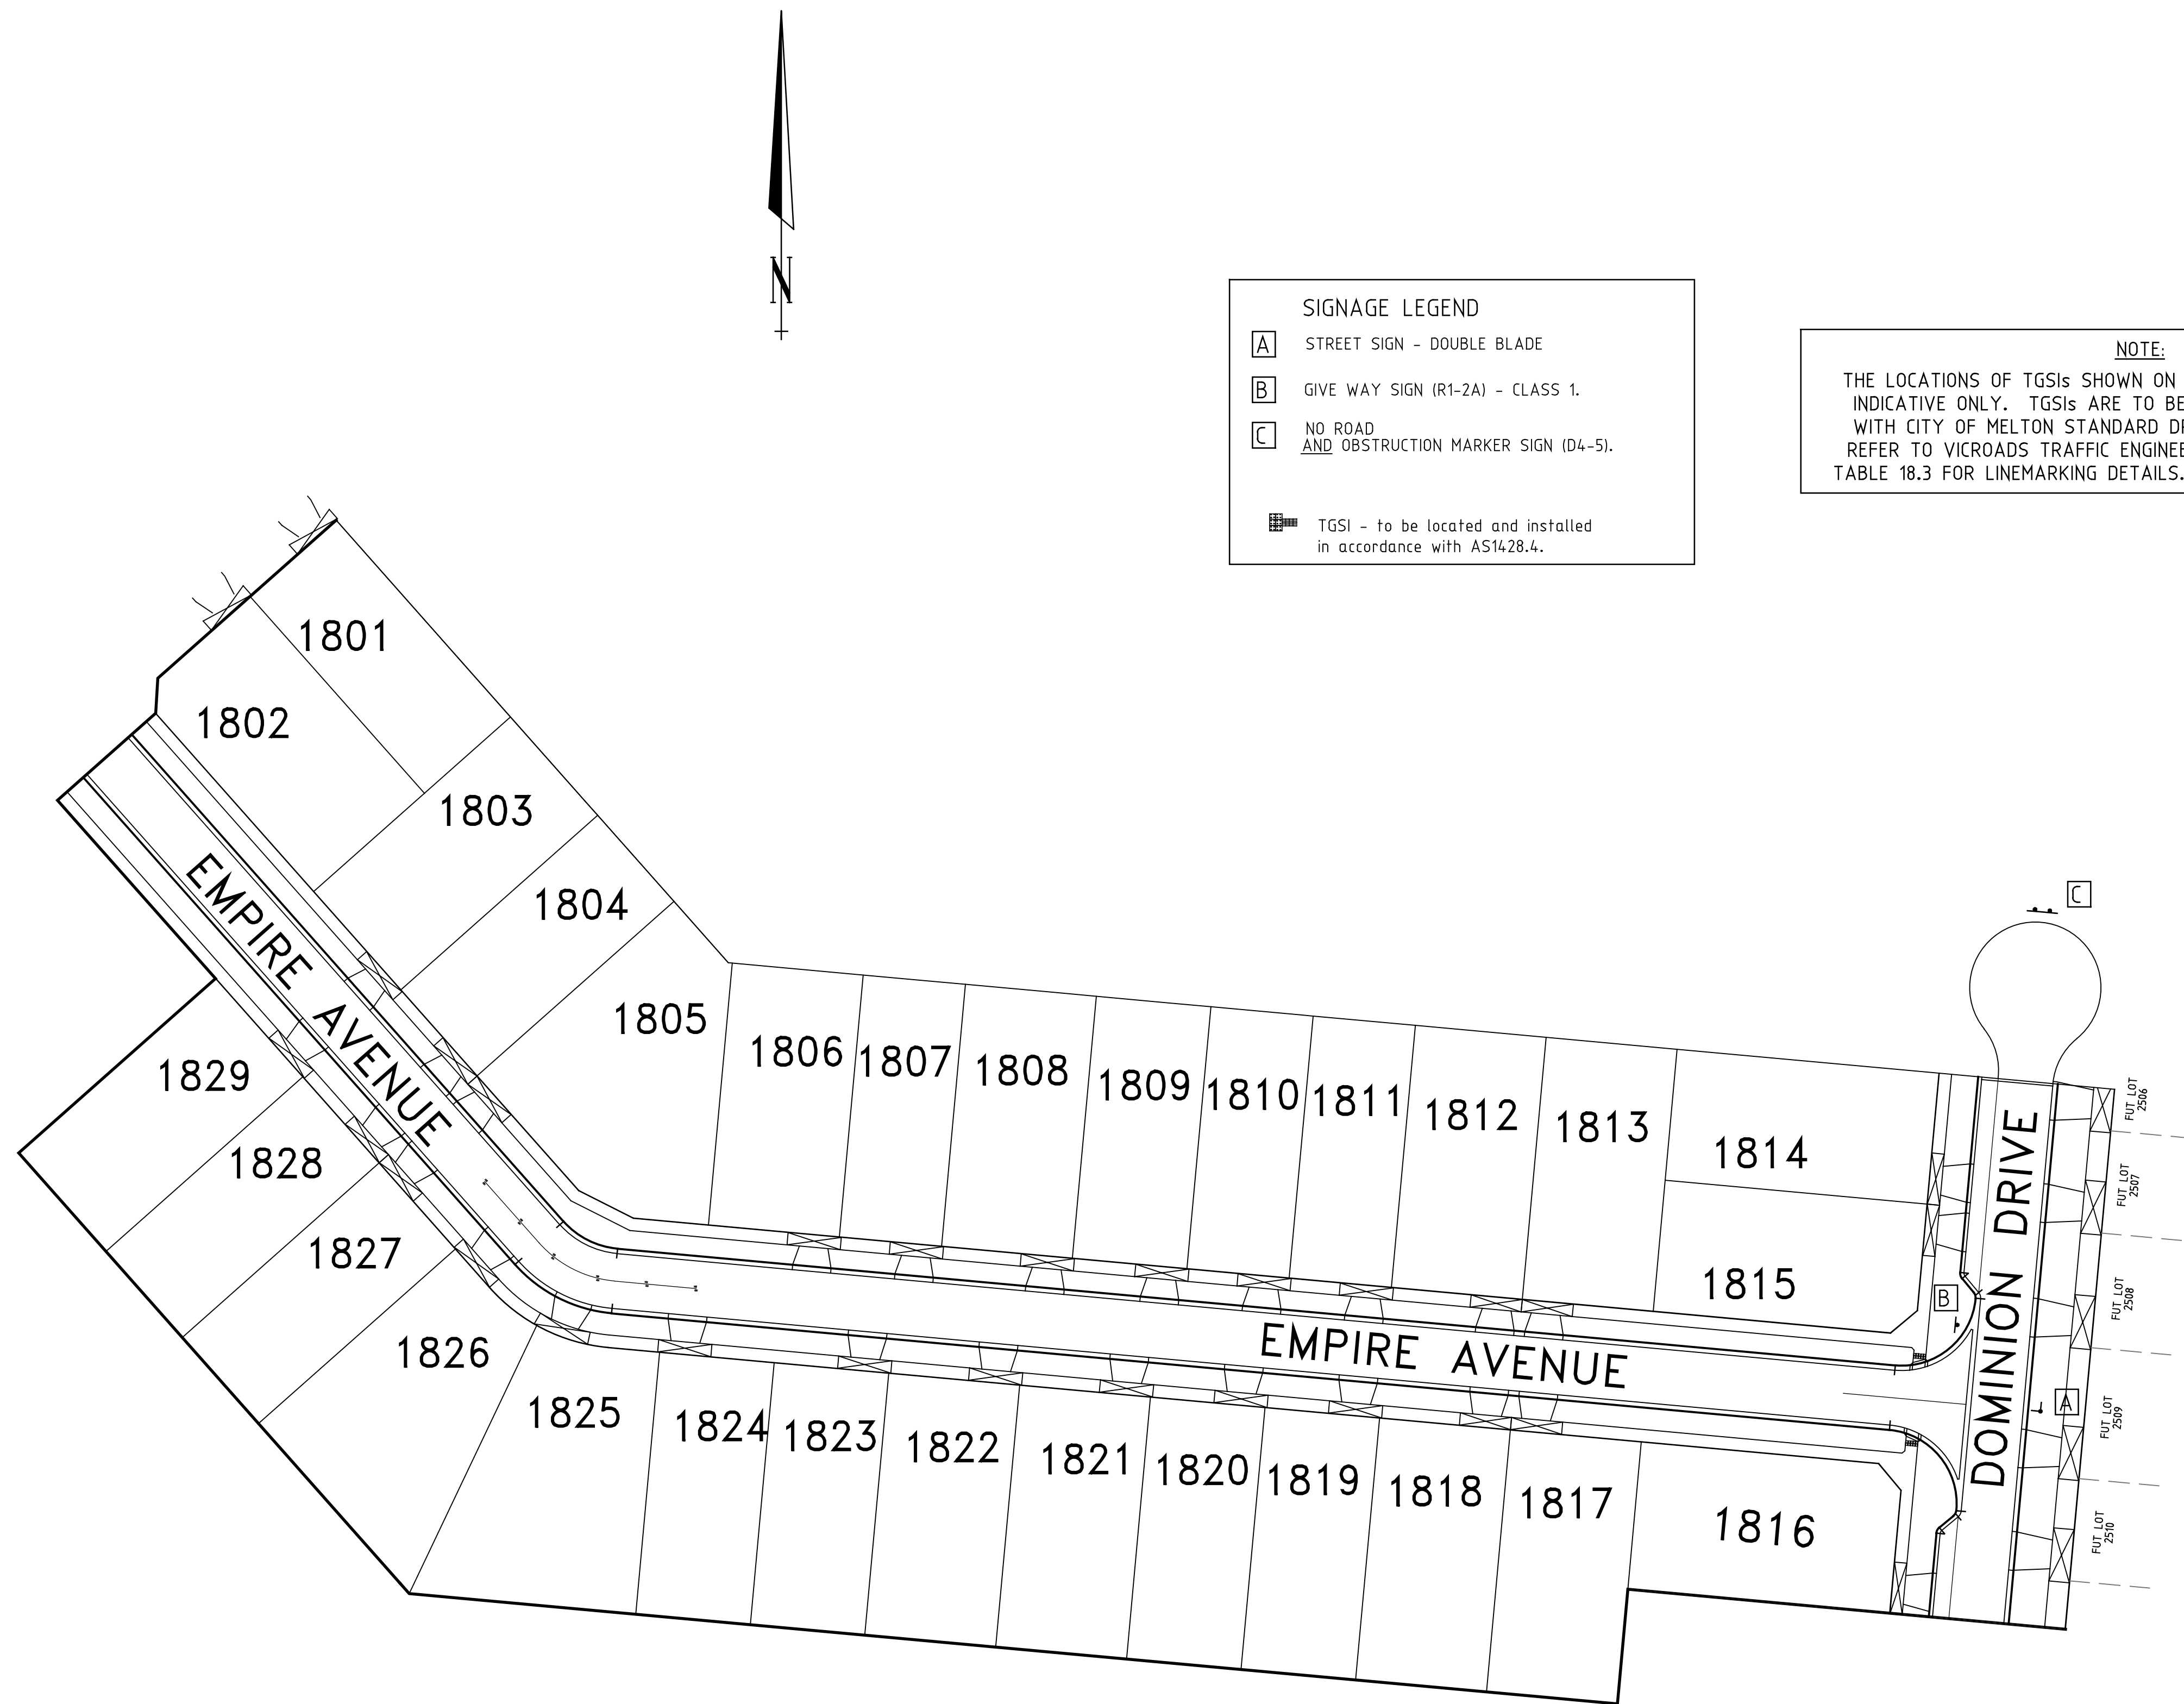

SIGNAGE LEGEND

A

STREET SIGN - DOUBLE BLADE

B

GIVE WAY SIGN (R1-2A) - CLASS 1.


C

NO ROAD AND OBSTRUCTION MARKER SIGN (D4-5).

TGSI - to be located and installed in accordance with AS1428.4.

NOTE:
THE LOCATIONS OF TGSIs SHOWN ON THESE PLANS ARE INDICATIVE ONLY. TGSIs ARE TO BE INSTALLED IN ACCORDANCE WITH CITY OF MELTON STANDARD DRAWING MCC 403 AND AS 1428.4. REFER TO VICROADS TRAFFIC ENGINEERING MANUAL VOLUME 2, TABLE 18.3 FOR LINEMARKING DETAILS.

SIGNAGE & LINEMARKING PLAN

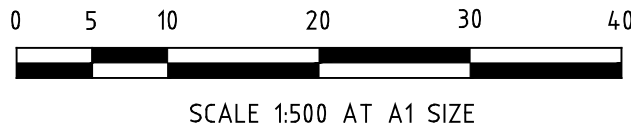

SCALE 1500 AT A1 SIZE

THESE DRAWINGS ARE TO BE USED ONLY FOR THE PURPOSE FOR WHICH THEY WERE INTENDED. NO RESPONSIBILITY WILL BE BORNE BY THE ENGINEERING CONSULTANT SHOULD THESE DRAWINGS BE USED FOR ANY OTHER PURPOSE.

AS CONSTRUCTED

C4	AS CONSTRUCTED ISSUE	10-4-19	J.B.											SCALE 1:500	
C3	1825 CROSSING AND FUT LAYOUT CHANGES	13-7-18	J.B.											LEVEL DATUM AHD	
C2	LOT 1824 VEHICLE CROSSING RELOCATED	16-5-18	J.B.											SHEET 13 OF 13	
C1	COUNCIL REQUIREMENTS	15-01-18	J.B.											DRAWING No.	
P1	PRELIMINARY ISSUE	20-10-17	L.P.											1275/18/NE/13	
REV.	REVISION	DATE	APPD.											REV.	
														C4	

LEGEND

G

GAS MAIN

W

WATER MAIN

R

RECYCLED WATER MAIN

E

ELECTRICITY CABLE

T

TELECOMMUNICATIONS CABLE

W

WATER CONDUIT

G

GAS CONDUIT

R

RECYCLED WATER CONDUIT

C

COMBINED SERVICES CONDUIT

T.B.M.

P.S.M.

H

HOUSE DRAIN PROPOSED/EX.

P

PROPERTY INLET, DRAINAGE PITS

D

EX./FUT. INLET, DRAINAGE PITS

S

DRAINAGE PIT STAGE/NUMBER

S

SEWER LINE AND STRUCTURES

S

EX./FUT. LINE AND STRUCTURES

K

KERB AND CHANNEL

K

EX./FUT. KERB AND CHANNEL

K

KERB TO BE REMOVED OFFSITE

S

STREET SIGN

C

CHAINAGES AND TANGENT POINTS

S

EXISTING SURFACE LEVEL

S

FINISHED LEVEL (TITLE BOUNDARY)

S

DESIGN TOP/TOE OF BATTER LEVEL

S

DESIGN PAVEMENT LEVEL

S

PROPOSED CONTOUR LINE & LEVEL

S

EXISTING CONTOUR LINE & LEVEL

S

FILLING IN EXCESS OF 200mm

S

CATCH DRAIN AND INVERT LEVEL

S

EX. BATTER

S

PROP. BATTER

22 Business Park Drive Notting Hill 3168

A.C.N. 006 550 803

E: consulting@dpmvic.com.au

W: www.dpmvic.com.au

T: (03) 9538 5000

Consulting Group

DRAWN: J.BEVERIDGE

DESIGNED: J.BEVERIDGE

CHECKED: L.PAPAZOIS

AUTHORISED: T.DAVOLI

DATE: 20-10-2017

AUTHORITY: CITY OF MELTON

PROJECT: MODEINA STAGE 18

DETAILS: SIGNAGE & LINEMARKING PLAN